

021

9-9-60 WATER WELL DRILLERS LOG

Date: 9-9-1960, Driller: J L [unclear] **CODED**

	Description & Color of Materials Sand, Clay, Red Clay, Shell, etc.	Thick- ness Feet	Depth Feet
(1) Owner of Land: <u>Charism wear</u> (Name)	soil clay	35	30
<u>Hickory 2-1st</u> (Address)	sand	20	40
(2) Location: <u>1/4 Sec 3 T2 R16</u>	white	20	60
<u>5</u> miles <u>North</u> of <u>Hickory</u> (distance) (direction) (Nearest Town)	black shale	300	360
(3) Topography: <u>Hilly</u> (Hilly) (Flat) (Level)	rock	20	380
(4) Purpose of Well: <u>Domestic</u> (Domestic Irrigation Municipal, Industrial, Other)	black sandstone	100	480
	rock & sandstone	40	520

Information upon completion of well:

(1) Diameter 4 inches.

(2) Total Depth 580 feet.

(3) Water Level 83 feet below top of ground.

(4) Cased to 147, Size 4"


(5) Screen: Size _____, Length _____

(6) Were any formations sealed against pollution?
_____ yes, _____ no.

If YES depth of formation _____

Why _____

Drillers Remarks: _____

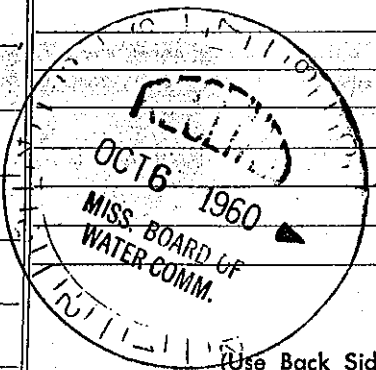

Well No.