

045

BENTON

MISSISSIPPI BOARD OF WATER COMMISSIONERS

8-12-60

WATER WELL DRILLERS LOG


Date: 8-12, 1960, Driller: J. S. [unclear] county [unclear]

(1) Owner of Land: OA [unclear]  
 (Name)  
 (Address) 5375 R 1 E  
 (2) Location: 1/4, 8 1/4, Sec. 3 T 5 R 1 E  
1 1/2 miles north of [unclear] (Nearest Town)  
 (distance) (direction)  
 (3) Topography: flat  
 (Hilly) (Flat) (Level)  
 (4) Purpose of Well: Domestic  
 (Domestic, Irrigation, Municipal, Industrial, Other)

Description & Color of Materials Sand, Clay, Red Clay, Shell, etc.	Thickness Feet	Depth Feet
<u>blue clay</u>	<u>60</u>	<u>60</u>
<u>sand</u>	<u>10</u>	<u>70</u>
<u>blue shale</u>	<u>260</u>	<u>300</u>
<u>rock</u>	<u>20</u>	<u>320</u>
<u>blue limestone</u>	<u>100</u>	<u>420</u>
<u>rock &amp; shales</u>	<u>20</u>	<u>440</u>
<u>hard rock</u>	<u>70</u>	<u>510</u>

Information upon completion of well:

(1) Diameter 4 inches.  
 (2) Total Depth 570 feet.  
 (3) Water Level 44 feet below top of ground.  
 (4) Cased to 148, Size 4"  
 (5) Screen: Size \_\_\_\_\_, Length \_\_\_\_\_  
 (6) Were any formations sealed against pollution?  
 \_\_\_\_\_ yes, \_\_\_\_\_ no.  
 If YES depth of formation \_\_\_\_\_  
 Why \_\_\_\_\_  
 Drillers Remarks: \_\_\_\_\_

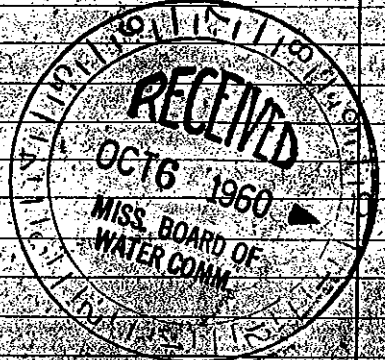

(Use Back Side)

Mail this copy to Board of Water Commissioners 429 Miss. St. Jackson, Miss.

Well No.