

# State Well Report

## Part 1

Mississippi Department of Environmental Quality  
Office of Land and Water Resources  
P.O. Box 10631  
Jackson, MS 39289-0631  
(601)961-5210  
(601)354-6938 (fax)

For Office Use Only:

Aquifer: 050  
Well #: \_\_\_\_\_  
L. S. Elevation: \_\_\_\_\_  
E-log #: \_\_\_\_\_

County: Benton  
Permit #: \_\_\_\_\_  
Driller: Leeper Drilling  
Date drilling completed: 11-25-09

State Law requires that this report be prepared by the driller in detail and filed with the Department within 30 days of completion of drilling of the well.

### Well Owner Information

Owner Name: Hill Pleasant Baptist Church  
Mailing Address: c/o Curry Howell  
1057 CR 68  
Myrtle, MS 38650  
City State Zip Code  
Telephone No. (662) 988-3347

### Well Location

Latitude: 34.36.55 Longitude: 89.09.06  
Method of Lat/Long (circle one): Conventional Survey, USGS quad, Hand-held GPS, Survey-grade GPS  
SE SW NE NW Sec 2 Twn 5S Rng 1E  
Distance 2 Miles Direction South of Nearest Town Hickory Flat

### Well Data

Purpose of Well (circle one) Home Industrial Public Supply Irrigation Fish Culture Other: \_\_\_\_\_  
Date well drilling started: 11-16-09 Date well drilling completed: 11-25-09  
If flowing, method of flow regulation: Valve \_\_\_\_\_ Other (describe) \_\_\_\_\_  
Static Water Level: 120 feet above or below (circle one) land surface Date measured: 11-28-09  
Method of Measurement (circle one) steel tape electric tape air line other: \_\_\_\_\_  
Hole depth: 460 ft Well depth: 460 ft Well grouted to a depth of 10 feet  
Type of grout (circle one): Cement Bentonite Mix  
Casing length: 340 feet Casing diameter: 4 inches Type of casing: PVC  
Screen length: 40 feet Screen diameter: 2 inches Type of screen: PVC  
Screen slot size: .013 inches Setting depth: From 420 feet to 460 feet  
Type of completion (circle all applicable): Gravel packed Underreamed Telescoped Open hole Natural Development  
Other (describe): \_\_\_\_\_  
Top of lap pipe or reduction in casing: \_\_\_\_\_ feet. If telescoped or more than one screen, describe on back of page  
Logs run (circle all applicable): No log run Electric Gamma Ray Density Sonic Neutron Other: \_\_\_\_\_  
Name of organization running log(s): \_\_\_\_\_

I certify that the well was drilled, constructed, and completed in accordance with all applicable requirements of the Mississippi Department of Environmental Quality and/or the Mississippi Department of Health regulations and state laws.


Print Name of Water Well Contractor and License No. Leeper Drilling # 0079

Signature of Water Well Contractor [Signature]

RECEIVED  
DEC 1 2009  
3040148

If well telescopes please sketch below and show depths.


0 50

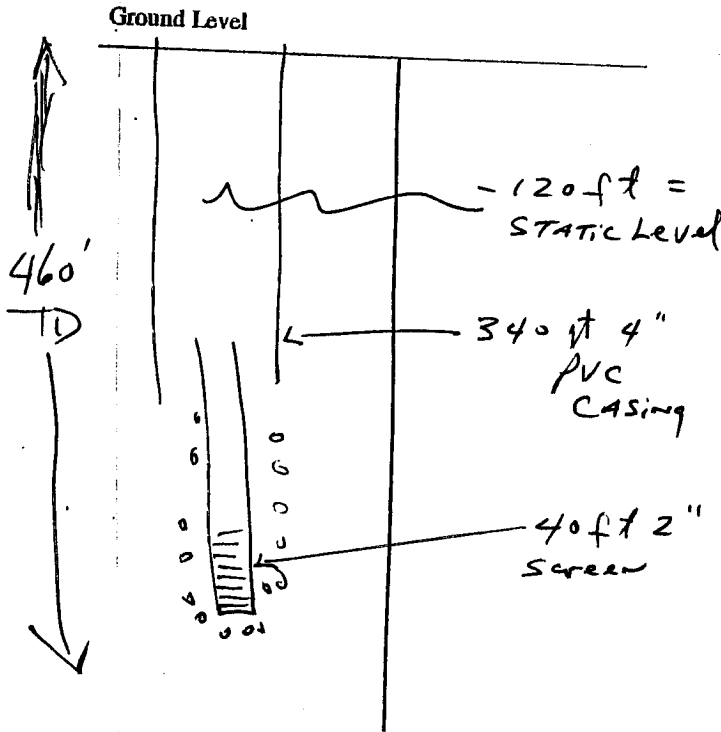

Description of Formations Encountered	From	To
TOP Gumbo	0	20
Black clay	20	330
CHALK	330	420
SAND	420	460

If more than one screen, show location of each on sketch

Sketch the property layout and include the following: 1) the well location; 2) any permanent structures on the property that may aid in locating the well; 3) any roads, power lines, or other items that may aid in locating the property and the well; 4) indicate direction.

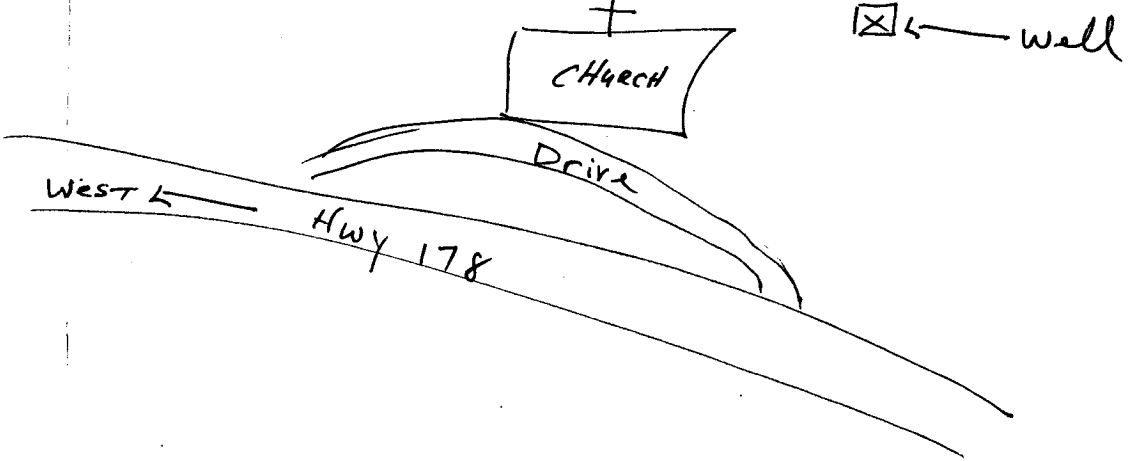

Landowner Name: Pleasant Hill Baptist Church

Signature of Water Well Contractor [Signature]

RECORDED  
 DEC 18 2019  
 BY: C/M/R

# STATE WELL REPORT

## Part 2

Pump Installer's Completion Report  
Mississippi Department of Environmental Quality  
Office of Land and Water Resources  
P.O. Box 10631  
Jackson, MS 39289-0631  
(601)961-5210  
(601)354-6938 (fax)

For Office Use Only:

Aquifer: 050

Well #: \_\_\_\_\_

Elevation: \_\_\_\_\_

County: Benton

Permit #: \_\_\_\_\_

Driller: Leeper Drilling

Date completed: 11-28-09

This report should be prepared by the pump installer in detail and filed with the Department within 30 days of the installation of pump.

### Well Owner Information

Owner Name: Pleasant Hill Baptist Church

Mailing Address: c/o Curry Howell

1057 CR 68

Myrtle MS 38650  
City State Zip Code

Telephone No. (662) 988-3347

### Well Location

Latitude: \_\_\_\_\_ Longitude: \_\_\_\_\_

Method of Lat/Long (circle one): Conventional Survey,

USGS quad, Hand-held GPS, Survey-grade GPS

1/4 1/4 Sec 25 Twn 55 Rng 1E

Distance Direction Nearest Town

2 Miles S of Hickory Flat

### Pump Type Circle one

Air Lift

Jet

Submersible

Bucket

Piston

Turbine

Centrifugal

Rotary

Flowing Well

Other (specify): \_\_\_\_\_

Date Pump Installed: 11-28-09

Rated Pump Capacity: 10 Gallons Per Minute

### Power Type Circle one

Diesel Engine

Gasoline Engine

Natural Gas

Electric Motor

Hand

Tractor PTO

Windmill

Other (specify): \_\_\_\_\_

Horse Power Rating of Motor: 3/4 HP

Setting Depth: 160 feet

Number of Stages: 8

### Pump Test Data

Date Well Tested: 11-28-09

Static Water Level (A): 120 Feet Below Land Surface

Pumping Water Level (B): \_\_\_\_\_ Feet Below Land Surface

Drawdown [(B) - (A)]: \_\_\_\_\_ Feet Below Land Surface

Test Pumping Rate: \_\_\_\_\_ Gallons Per Minute

Duration of Pump Test (minimum 4 hours): \_\_\_\_\_ hours

### Method of Measuring Water Level Circle one

Air Line

Electric Measuring Line

Steel Tape

Other (specify): \_\_\_\_\_

For flowing well, measured shut in head: \_\_\_\_\_ feet

Well yielded \_\_\_\_\_ GPM with a drawdown of \_\_\_\_\_ feet after \_\_\_\_\_ hours of pumping

I HEREBY CERTIFY that the above statements are true to the best of my knowledge.

Leeper Drilling

Print Name of Pump Installer and License No. (if applicable)

[Signature]  
Signature of Pump Installer