

BENTON

2000
7-18-62

WATER WELL DRILLERS LOG

Date: July 16, 1962 Driller: Ed Lot Mill Co County: union

(Name)

(1) Owner of Land: Y R Beaton
(Name)
Hickelot miss
(Address)

(2) Location: 1/4, 1/4, Sec. T R
1 miles East of Hickelot
(distance) (direction) (Nearest Town)

(3) Topography: flat
(Hilly) (Flat) (Level)

(4) Purpose of Well: Home use
(Domestic Irrigation
Municipal, Industrial, Other)

Description & Color of Materials Sand, Clay, Red Clay, Shell, etc.	Thick- ness Feet	Depth Feet
<u>clay</u>	<u>20</u>	<u>20</u>
<u>hard shmp.</u>	<u>42</u>	<u>62</u>
<u>blue mot.</u>	<u>80</u>	<u>142</u>

Information upon completion of well:

(1) Diameter 4 inches.

(2) Total Depth 470 feet.

(3) Water Level 80 feet below top of ground.

(4) Cased to 86, Size 4


(5) Screen: Size 0, Length _____

(6) Were any formations sealed against pollution?
_____ yes, X no.

If YES depth of formation _____

Why _____

Drillers Remarks: Left Driller

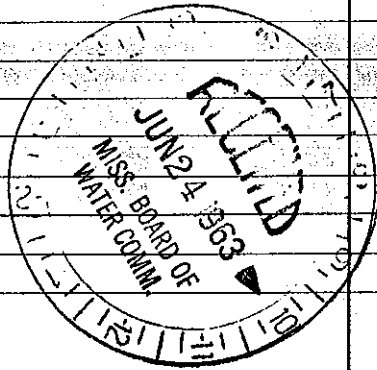

(Use Back Side)

Well No.

ail this copy to Board of Water Commissioners 429 Miss. St. Jackson, Miss.