

BENTON MISSISSIPPI BOARD OF WATER COMMISSIONERS

0 2005
11-16-63

WATER WELL DRILLERS LOG

Date: Nov 16, 1963, Driller: John D. ... County Benton
(Name)

(1) Owner of Land: <u>Mont Thompson</u> (Name)	Description & Color of Materials Sand, Clay, Red Clay, Shell, etc.	Thick- ness Feet	Depth Feet
<u>Hickory Flat Miss</u> (Address)			
(2) Location: <u>1/4</u> , <u>1/4</u> , Sec. <u>T</u> <u>R</u>			
<u>12</u> miles <u>north</u> , of <u>New Albany Miss</u> (distance) (direction) (Nearest Town)			
(3) Topography: <u>None used</u> (Hilly) <input checked="" type="checkbox"/> (Flat) (Level)			
(4) Purpose of Well: (Domestic Irrigation Municipal, Industrial, Other)			

Information upon completion of well:

(1) Diameter 4 inches.

(2) Total Depth 572 feet.

(3) Water Level 120 feet below top of ground.

(4) Cased to 87, Size 4


(5) Screens: Size none, Length _____

(6) Were any formations sealed against pollution?
 yes, _____ no.

If YES depth of formation 200 ft capping to 450 ft.

Why _____

Drillers Remarks: _____

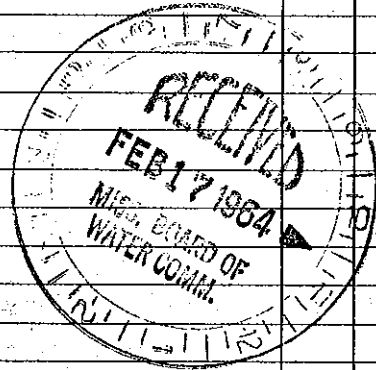

Well No.

(Use Back Side)

Mail this copy to Board of Water Commissioners 429 Miss. St. Jackson, Miss.