

BENTON MISSISSIPPI BOARD OF WATER COMMISSIONERS


2006
12-7-63
WATER WELL DRILLERS LOG

Date: Dec 7, 1963, Driller: Pat Hannon County Benton
(Name)

(1) Owner of Land: <u>J.A. Raficor</u> (Name) <u>Patco Comp. Miss</u> (Address)	Description & Color of Materials Sand, Clay, Red Clay, Shell, etc. <u>Red clay</u> <u>Blue sand</u>	Thick- ness Feet <u>40</u> <u>50</u>	Depth Feet <u>20</u> <u>80</u>
(2) Location: _____ 1/4, _____ 1/4, Sec. _____ T. _____ R. _____ <u>10</u> miles <u>E</u> of <u>Patco Miss</u> (distance) (direction) (Nearest Town)			
(3) Topography: _____ (Hilly) <input checked="checked" type="checkbox"/> (Flat) (Level)			
(4) Purpose of Well: <u>House well</u> (Domestic Irrigation Municipal, Industrial, Other)			

Information upon completion of well:

- (1) Diameter 4 inches.
- (2) Total Depth 597 feet.
- (3) Water Level 6 feet below top of ground.
- (4) Cased to 106, Size 4.
- (5) Screen: Size none, Length _____.
- (6) Were any formations sealed against pollution?
____ yes, ____ no.

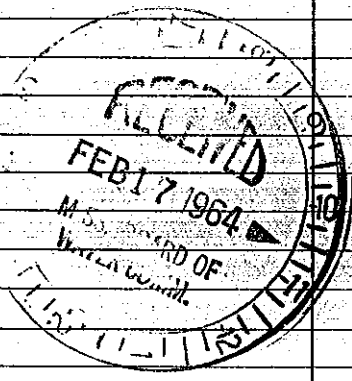

If YES depth of formation _____
Why _____
Drillers Remarks: _____

Retain this copy for your office files.

(Use Back Side)

Well No.