

BENTON MISSISSIPPI BOARD OF WATER COMMISSIONERS

0 2008

6-20-66 WATER WELL DRILLERS LOG

Date: June 29 1966, Driller: Larry Carpenter County Benton
 (Name)

(1) Owner of Land:	Description & Color of Materials Sand, Clay, Red Clay, Shell, etc.	Thick- ness Feet	Depth Feet
<u>Charles Tyer</u> (Name) <u>Hickory Flat, Miss</u> (Address)	<u>Surface Soil</u>	<u>20</u>	
(2) Location: <u>1/4</u> , <u>1/4</u> , Sec. <u>T. R.</u>	<u>Red sand and Clay mixed from 20 ft. to 70 ft.</u>	<u>58</u>	
_____ miles _____ of _____ (distance) (direction) (Nearest Town)	<u>White sand and Clay from 70 ft. to 110 ft.</u>	<u>40</u>	
(3) Topography: <u>Hilly</u> (Hilly) (Flat) (Level)	<u>Blue mud from 110 ft. to 385 ft.</u>	<u>275</u>	
(4) Purpose of Well: <u>Resident</u> (Domestic Irrigation Municipal, Industrial, Other)			

Information upon completion of well:

(1) Diameter 4 inches.

(2) Total Depth 464 feet.


(3) Water Level 90 feet below top of ground.

(4) Cased to 210, Size 4 in.

(5) Screen: Size none, Length _____

(6) Were any formations sealed against pollution?
 _____ yes, X no.

<u>White coarse sand</u>	<u>4.5</u>	
<u>and Hard white Round Rocks from 385 ft. to 430 ft.</u>		
<u>Blue mud from 430 ft. to 464 ft.</u>	<u>34</u>	

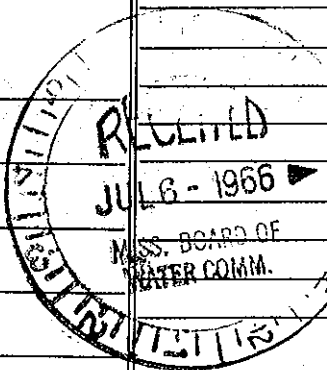

Well located 2 1/2 miles
 East of Hickory Flat
 on Old 78 Hwy.
 on NW 1/4 of Hwy.
 (Use Back Side)

Well No.