, ,	<b>State Well Report</b>	C - Off - U - O-l-
County: Tisonh	Part 1 - Driller's Log	For Office Use Only:
Permit #:	Mississippi Department of Environmental Quality Office of Land and Water Resources	Aquifer:
	P.O. Box 10631	Well #:
Driller:	Jackson, MS 39289-0631	L. S. Elevation:
Date drilling completed: 9/30/08	(601)961-5210 (601)354-6938 (fax)	E-log #:
	(001)334-0336 (1ax)	L-log m.
	ort be prepared by the license holder responsible for	=
Department at the above address Information on Well	s within 30 days of completion of drilling of the well	<i>ll or borehole.</i> Forehole Location
(Landowner if borehole is not )	for a water wall	
Owner Name Rose	Latitude: 1 ° 36 ', 36	" Longitude: <b>89° 07</b> ')
	Method of Lat/Long (circle of	one): Conventional Survey,
Mailing Address: 2327 Wak		d GPS, Survey-grade GPS
		_
CALD WATER	MS 38(18 - 4 Sec_3)	L Twn ZS Rng
Cold WAKE	ate Zip Code Distance Direction	Nearest Town of Hickory Flay
Telephone No. (901) 130-898	$\frac{4}{3}$ Miles $\frac{3}{3}$	of Hickory MAY
Total and the contract of the		
•	rilling completed: 4/36/88 Hole depth: 470	Hole diameter:
Location of the source of any surface wat Method of dosing and volume of Chlorin	•	
Location of the source of any surface wat Method of dosing and volume of Chlorin Logs run (circle all applicable). No log run Name of organization running log(s).	er used for drilling:  e used in drilling and development:  SPPM	Other:
Location of the source of any surface wat Method of dosing and volume of Chlorin Logs run (circle all applicable). No log run Name of organization running log(s).  Purpose of borehole (check one): Water W	er used for drilling:  le used in drilling and development:  SPPM  In Electric Gamma Ray Density Sonic Neutron  Vell Geotechnical/Geological Investigation Ground	Other:
Location of the source of any surface wat Method of dosing and volume of Chlorin Logs run (circle all applicable. No log run Name of organization running log(s).  Purpose of borehole (check one): Water W. Seismic	er used for drilling:  used in drilling and development:  Electric Gamma Ray Density Sonic Neutron	Other:d Source Heat Pump
Location of the source of any surface wat Method of dosing and volume of Chlorin Logs run (circle all applicable). No log run Name of organization running log(s).  Purpose of borehole (check one): Water W	er used for drilling:  le used in drilling and development:	Other:d Source Heat Pump
Location of the source of any surface wat Method of dosing and volume of Chlorin Logs run (circle all applicable). No log run Name of organization running log(s).  Purpose of borehole (check one): Water W	er used for drilling:  the used in drilling and development:SPPM  The used in drilling and development:SPPM  The used in drilling and development:SPPM  The used in drilling:  The used in drilling:  The used in drilling:  The used in development:SpPM  The used in drilling:SpPM  The used in drilling and development:SpPM  The used in drilling and development:	Other: d Source Heat Pump  lock Other:
Location of the source of any surface wat Method of dosing and volume of Chlorin Logs run (circle all applicable). No log run Name of organization running log(s).  Purpose of borehole (check one): Water W	er used for drilling:  the used in drilling and development:	Other:  d Source Heat Pump  lock Other:
Location of the source of any surface wat Method of dosing and volume of Chlorin Logs run (circle all applicable). No log run Name of organization running log(s).  Purpose of borehole (check one): Water W	er used for drilling:  the used in drilling and development:	Other: d Source Heat Pump  lock Other:
Location of the source of any surface wat Method of dosing and volume of Chlorin Logs run (circle all applicable). No log run Name of organization running log(s).  Purpose of borehole (check one): Water W	er used for drilling:  the used in drilling and development:	Other:  d Source Heat Pump  lock Other:  9/30/08
Location of the source of any surface wat Method of dosing and volume of Chlorin Logs run (circle all applicable). No log run Name of organization running log(s).  Purpose of borehole (check one): Water Level:	rer used for drilling:  the used in drilling and development:	Other:  d Source Heat Pump  lock Other:  9/30/08  ment Bentonite Mix  PV C
Location of the source of any surface wat Method of dosing and volume of Chlorin Logs run (circle all applicable). No log run Name of organization running log(s).  Purpose of borehole (check one): Water Level:	er used for drilling:  the used in drilling and development:	Other:  d Source Heat Pump  lock Other:  9/30/08  ment Bentonite Mix  PV C
Location of the source of any surface wat Method of dosing and volume of Chlorin  Logs run (circle all applicable). No log run Name of organization running log(s).  Purpose of borehole (check one): Water	rer used for drilling:  the used in drilling and development:	Other:  d Source Heat Pump  lock  Other:  9/30/08  ment Bentonite Mix  PV C  PV C

Top of lap pipe or reduction in casing: feet. If telescoped or more than one screen, describe on next page

Form: OLWR-SWR-1A

RECEIVED

OCT 2 4 2008

BY: OLWR

## STATE WELL REPORT

## County: Permit #:

## Part 2

Pump Installer's Completion Report
Mississippi Department of Environmental Quality
Office of Land and Water Resources P.O. Box 10631 Jackson, MS 39289-0631 (601)961-5210

(601)354-6938 (fax)


For Office Use Only:	
Aquifer:	;
Well#: P-21 Elevation:	

Copy information from block on Part 1 (601)32	4-6938 (lax)		
This part of the report must be completed by a licensed water well contractor or a licensed pump installer. A copy of Part 1 of the report must be attached and both parts filed with the Department at the above address within 30 days of well completion.			
Well Owner Information	Well Location		
o y Roccoop	Tourisday		
Owner Name: Son Bossege	Latitude:Longitude:		
Mailing Address: 2327 WakeField Rd	Method of Lat/Long (check one): Conventional Survey,		
·····	USGS quad, Hand-held GPS, Survey-grade GPS		
Cold Water ns 38 6/8 State Zip Code	¼¼ Sec. 32 T.55 R.2.E		
City State Zip Code	Distance Direction Nearest Town		
Telephone No. ( 90/- 130-8987	4 Miles SW of Hickory Play, MS		
Pump Type	Power Type		
Circle one	Circle one		
Air Lift Jet Submersible	Diesel Engine Gasoline Engine Natural Gas		
Bucket Piston Turbine	Electric Motor Hand Tractor PTO		
Centrifugal Rotary Flowing Well	Windmill Other (specify):		
Other (specify):	Horse Power Rating of Motor:		
Date Pump Installed: 9/3008	Setting Depth: 252 feet		
Rated Pump Capacity:	Number of Stages:		
Pump Test Data	Method of Measuring Water Level		
Date Well Tested: 9/30/08	Circle one		
Static Water Level (A): 157 Feet Below Land Surface	Air Line Electric Measuring Line Steel Tape		
	Other (specify):		
Pumping Water Level (B): 190 Feet Below Land Surface			
Drawdown [(B) – (A)]: 33 Feet Below Land Surface	For flowing well, measured shut in head:feet		
Test Pumping Rate:Gallons Per Minute	Well yieldedGPM with a drawdown of		
Duration of Pump Test (minimum 4 hours):hours	feet afterhours of pumping		
I HEREBY CERTIFY that the above statements are true to the best of my knowledge:			
Print Name of Pump Installer and License No. (if applicable)  Signature of Pump Installer			
Print Name of Pump Installer and License No. (if applicable)	Signature of Pump Installer Form: OLVVR-SWR-1B		


RECEIVED

OCT 2 4 2008

BY: OLWR

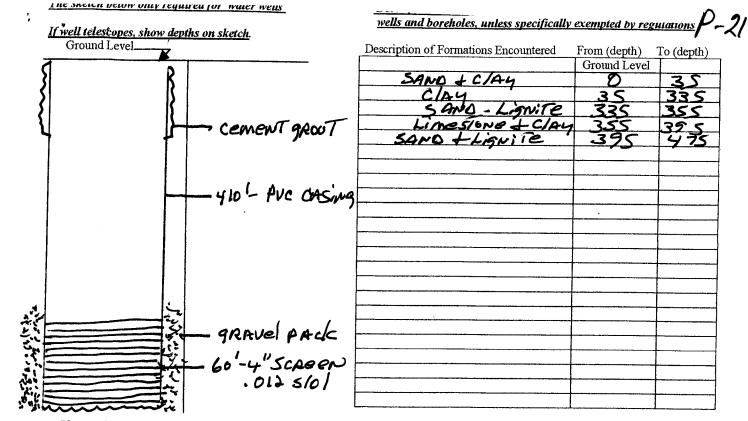

If more than one screen, show location of each on sketch

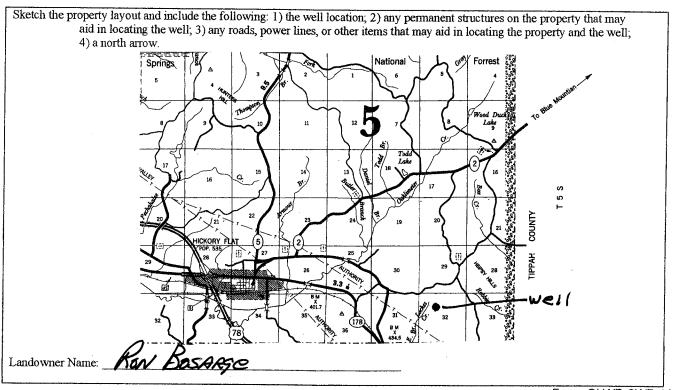

Form: OLWR-SWR-1A

I certify that the well/borehole was drilled, constructed, and completed in accordance with all applicable requirements of the Mississippi Department of Environmental Quality and the Mississippi Department of Health regulations, if applicable, and state

Print Name of Responsible Licensee and License No.

Signature of Licensee

RECEIVED

OCT 2 4 2008

BY: OLWR