

BOLIVAR

MISSISSIPPI BOARD OF WATER COMMISSIONERS

A-39

4-11-57

WATER WELL DRILLERS LOG

CODED

9/22/65
m 396

Date: April 11, 1957, Driller: Layne-Central Company County Bolivar

(Name)

(1) Owner of Land: Hynie Fisher
(Name)

Round Lake, Mississippi
(Address)

(2) Location: 1/4, 1/4, Sec. 17 T25R6

1 miles south of Round Lake
(distance) (direction) (Nearest Town)

(3) Topography: flat
(Hilly) (Flat) (Level)

(4) Purpose of Well: domestic
(Domestic Irrigation
Municipal, Industrial, Other)

Description & Color of Materials
Sand, Clay, Red Clay, Shell, etc.

Thick-
ness
Feet

Depth
Feet

Clay	14	14
Fine brown sand	16	30
Fine blue sand	30	60
Coarse sand	15	75
Coarse sand & pea gravel	76	151
Clay	44	195
Hard rock	2	197
Shell	13	210
Shell & streaks of fine sand	138	348
Gummy clay	54	402
Sand	27	429

Information upon completion of well:

(1) Diameter 3" inches.

(2) Total Depth 429 feet.

(3) Water Level 22 feet below top of ground.

(4) Cased to 420' Size 3"
1' lap in 3" casing

(5) Screen: Size 3", Length 10'
(Brass inserted screen)

(6) Were any formations sealed against pollution?


yes yes, no no.

If YES depth of formation Sealed with
mechanical seal and metal bottom.

Why

Drillers Remarks:

CODED

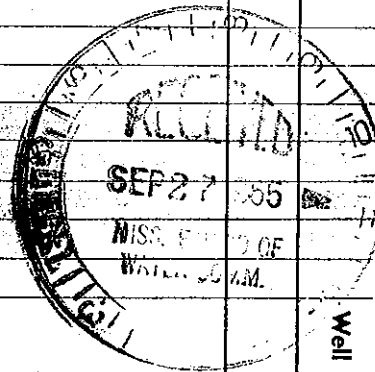

(Use Back Side)

Well No.

Mail this copy to Board of Water Commissioners 429 Miss. St. Jackson, Miss