

BOLIVAR MISSISSIPPI BOARD OF WATER COMMISSIONERS

A-42

6-30-62

WATER WELL DRILLERS LOG

CODED

A

Bolivar

Date: 6/30, 1962, Driller: Bailey Drilling Co. County: Washington

(Name)

(1) Owner of Land: A. J. Lowart
 Roundlake, Miss.
 (Name) (Address)

(2) Location: $\frac{1}{4}$, $\frac{1}{4}$, Sec. 5 T25R6
at Roundlake
 miles _____ of _____
 (distance) (direction) (Nearest Town)

(3) Topography: flat
 (Hilly) (Flat) (Level)

(4) Purpose of Well: Domestic
 (Domestic Irrigation
 Municipal, Industrial, Other)

| Description & Color of Materials Sand, Clay, Red Clay, Shell, etc. | Thick- ness Feet | Depth Feet |
|---|------------------------|---------------|
| Clay | 40 | 40 |
| Sand | 56 | 96 |
| Gravel & sand | 60 | 156 |
| Mud | 192 | 348 |
| Sand + Mud | 20 | 368 |
| Sand | 98 | 466 |
| Sand + Mud | 46 | 512 |
| Sand | 41 | 553 |
| Sand + Mud | 99 | 652 |
| Sand | 69 | 721 |
| Mud | 179 | 900 |
| Sand | 79 | 979 |
| Mud | 41 | 1020 |
| Sand, mud + rocks | 300 | 1320 |
| Fine sand | 38 | 1358 |
| Mud | 12 | 1370 |
| Sand | 60 | 1430 |

Information upon completion of well:

(1) Diameter: 4 x 2 inches

(2) Total Depth: 1430 feet.


(3) Water Level: 7 feet above top of ground.

(4) Cased to: all way size 4 x 2

(5) Screen: Size 2", Length 30 ft

(6) Were any formations sealed against pollution?
 _____ yes, X no.

CODED

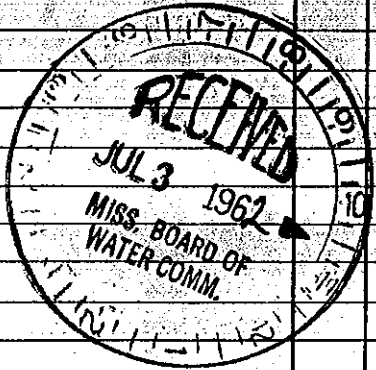

If YES depth of formation _____

Why _____

Drillers Remarks: _____

Well No.

(Use Back Side)

Mail this copy to Board of Water Commissioners 429 Miss. St. Jackson, Miss.