

**BOLIVAR** MISSISSIPPI BOARD OF WATER COMMISSIONERS

**A-43**

**7-11-63**

**WATER WELL DRILLERS LOG**

**CODED**

*Bolivar*

Date: 7-11, 1963, Driller: FIVE COUNTY FARMERS County: COAHOMA

(Name) WELKIN BOLIVAR

(1) Owner of Land: NORMAN BROWN  
 (Name)  
DUNCAN MISS  
 (Address) 7, 8 255  
**code 6**  
 (2) Location: 6  $\frac{1}{4}$ , 14, 15  $\frac{1}{4}$ , Sec. 25 6  
 (Nearest Town)  
3 miles West of DUNCAN  
 (distance) (direction) (Nearest Town)  
 (3) Topography: FLAT  
 (Hilly) (Flat) (Level)  
 (4) Purpose of Well: IRRIGATION  
 (Domestic Irrigation, Municipal, Industrial, Other)

Description & Color of Materials Sand, Clay, Red Clay, Shell, etc.	Thick- ness Feet	Depth Feet
<u>0-14 1/2' SANDY SOIL</u>	<u>0</u>	<u>14 1/2</u>
<u>RED SAND</u>	<u>14 1/2</u>	<u>21</u>
<u>BLUE MUD</u>	<u>21</u>	<u>23</u>
<u>COARSE SAND</u>	<u>23</u>	<u>34</u>
<u>Coarse sand &amp; pebbles</u>	<u>34</u>	<u>40 1/2</u>
		<u>99</u>

**CODED**

Information upon completion of well:

(1) Diameter 16 inches.

(2) Total Depth 99 feet.

(3) Water Level 20 feet below top of ground.

(4) Cased to 49 6, Size 6"


(5) Screen: Size 6", Length 48

(6) Were any formations sealed against pollution?  
 yes,  no,

If YES depth of formation \_\_\_\_\_

Why \_\_\_\_\_

Drillers Remarks:  
[Signature]

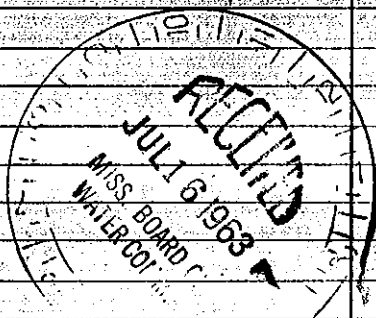

(Use Back Side)

Well No.

Mail this copy to Board of Water Commissioners 429 Miss. St. Jackson, Miss.