

Bolivar
A-44
6-16-64

MISSISSIPPI BOARD OF WATER COMMISSIONERS

WATER WELL DRILLERS LOG

A
Bolivar


Date: 6-16-64, 1964, Driller: Five County **CODED** ~~Patrick~~
(Name) *Wason*

(1) Owner of Land: <u>RT Gibson</u> (Name)	Description & Color of Materials Sand, Clay, Red Clay, Shell, etc.	Thick- ness Feet	Depth Feet
<u>Francis Minis</u> (Address)	0-47' Fine Sand	47	47
(2) Location: 1/4, 1/4, Sec. 31 T26 R6,	47-66 1/2 Coarse Sand	19 1/2	66 1/2
1 miles <u>North</u> of <u>Francis</u> (distance) (direction) (Nearest Town)	66 1/2 - 73 <u>small</u>		
(3) Topography: <u>By levee</u> (Hilly) (Flat) (Level)	Gravelly Sand	6 1/2	73
(4) Purpose of Well: <u>Irrigation</u> (Domestic Irrigation, Municipal, Industrial, Other)	Coarse sand 73-73	20	93
	Coarse Sand & gravel	6	99

Information upon completion of well:

- (1) Diameter 6 inches.
- (2) Total Depth 96 feet.
- (3) Water Level 20 feet below top of ground.
- (4) Cased to 47' 9" Size 6
- (5) Screen: Size 6, Length 48
- (6) Were any formations sealed against pollution?
_____ yes, _____ no.

If YES depth of formation _____
Why _____
Drillers Remarks: _____
Wason

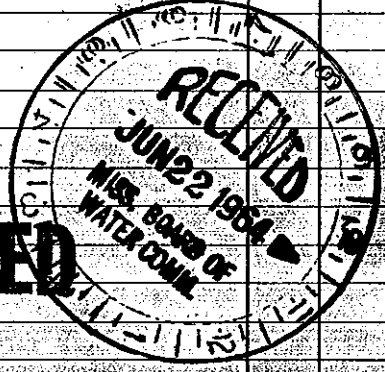

(Use Back Side)

Well No.

Mail this copy to Board of Water Commissioners 429 Miss. St. Jackson, Miss.