

BOLIVAR MISSISSIPPI BOARD OF WATER COMMISSIONERS

A-45

10-14-64

WATER WELL DRILLERS LOG

CODED

Date: 10-14, 1964, Driller: Frank Taylor County: Yazoo
(Name)

| (1) Owner of Land: <u>M.A. Bell</u> <small>(Name)</small> | Description & Color of Materials Sand, Clay, Red Clay, Shell, etc. | Thick- ness Feet | Depth Feet |
|-----------------------------------------------------------------------------------------------------------|-----------------------------------------------------------------------|------------------------|---------------|
| <u>Neeson Miss.</u> <small>(Address)</small> | <u>Clay</u> | <u>0</u> | <u>15</u> |
| (2) Location: <u>1/4</u> , <u>1/4</u> , Sec. <u>8</u> T <u>25</u> R <u>6</u> | <u>And ground</u> | <u>15</u> | <u>50</u> |
| <u>3/4</u> miles <u>flat</u> of <u></u> <small>(distance) (direction) (Nearest Town)</small> | <u>Clay</u> | <u>150</u> | <u>590</u> |
| (3) Topography: <u>flat</u> <small>(Hilly) (Flat) (Level)</small> | <u>upward</u> | <u>390</u> | <u>432</u> |
| (4) Purpose of Well: <u>Dom.</u> <small>(Domestic Irrigation Municipal, Industrial, Other)</small> | | | |

Information upon completion of well:


- (1) Diameter 2 inches.
- (2) Total Depth 441 feet.
- (3) Water Level 40 feet below top of ground.
- (4) Cased to 432, Size 2"
- (5) Screen: Size 1/4", Length 6'
- (6) Were any formations sealed against pollution?
 yes, no.

If YES depth of formation _____

Why _____

Drillers Remarks: _____

CODED

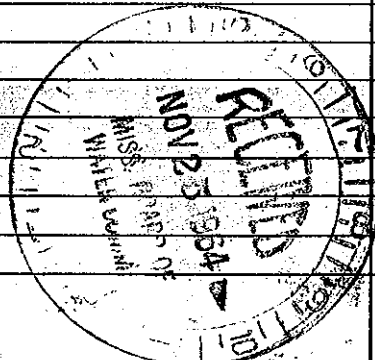

(Use Back Side)

Well No. 11

Mail this copy to Board of Water Commissioners: 429 Miss. St. Jackson, Miss