

Bolivar MISSISSIPPI BOARD OF WATER COMMISSIONERS

A-46
4-66

WATER WELL DRILLER **CODED**

Date: 4-4-1966, Driller: Five County Farmers Assoc County Bolivar
(Name)

(1) Owner of Land: <u>RUDOLPH MASSEY</u> (Name) <u>Deeson MISS</u> (Address)	Description & Color of Materials Sand, Clay, Red Clay, Shell, etc.	Thick- ness Feet	Depth Feet
(2) Location: $\frac{1}{4}$, $\frac{1}{4}$, Sec. <u>28 T25R7</u> <u>3</u> miles <u>EAST</u> of <u>Deeson</u> (distance) (direction) (Nearest Town)	<u>Clay.</u>		<u>14</u>
(3) Topography: <u>flat</u> (Hilly) (Flat) (Level)	<u>Blue clay -</u>	<u>4 5/8</u>	<u>57 1/2</u>
(4) Purpose of Well: <u>Irrigation</u> (Domestic, Irrigation, Municipal, Industrial, Other)	<u>Sand & pea gravel</u>	<u>6 1/2</u>	<u>66</u>
	<u>Sand, gravel & lignite</u>	<u>19 1/2</u>	<u>85 1/2</u>
	<u>Sand, Gravel + Log.</u>	<u>6 1/2</u>	<u>92</u>
	<u>Sand, Gravel, lignite</u>	<u>6 1/2</u>	<u>98 1/2</u>
	<u>Coarse sand + gravel</u>	<u>19 1/2</u>	<u>118</u>

Information upon completion of well:


- (1) Diameter 6 inches.
- (2) Total Depth 113' 4" feet.
- (3) Water Level 20' feet below top of ground.
- (4) Cased to 65' 4", Size 6
- (5) Screen: Size 6", Length 48"
- (6) Were any formations sealed against pollution?
_____ yes, _____ no.

If YES depth of formation _____

Why _____

Drillers Remarks: _____

CODED

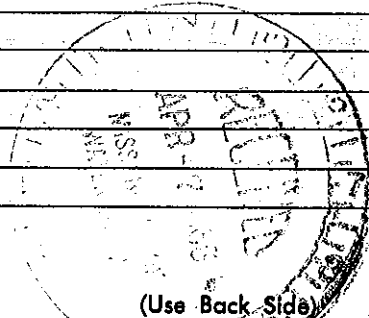

(Use Back Side)

Well No.

Mail this copy to Board of Water Commissioners 429 Miss. St. Jackson, Miss.