

Bolivar MISSISSIPPI BOARD OF WATER COMMISSIONERS

A-47

4-66

WATER WELL DRILLERS LOG

CODED

Date: 4-5, 1966, Driller: Bill County Sumner County, Bolivar (Name)

(1) Owner of Land: Robert W. Massey
 (Name)
Deesa Miss
 (Address)
 (2) Location: 1/4, 1/4, Sec. 28 T25R
3 miles East, of Deesa
 (distance) (direction) (Nearest Town)
 (3) Topography: Flat
 (Hilly) (Flat) (Level)
 (4) Purpose of Well: Irrigation
 (Domestic Irrigation
 Municipal, Industrial, Other)


Description & Color of Materials Sand, Clay, Red Clay, Shell, etc.	Thick- ness Feet	Depth Feet
<u>Clay</u>		<u>20 1/2</u>
<u>yellow sand + clay</u>	<u>69</u>	<u>27</u>
<u>hard sand</u>	<u>52</u>	<u>79</u>
<u>Coarse sand & gravel</u>	<u>40</u>	<u>118</u>

Information upon completion of well:

(1) Diameter 6 inches.
 (2) Total Depth 113¹⁰ feet.
 (3) Water Level 20' feet below top of ground.
 (4) Cased to 65'^{10"}, Size 6"
 (5) Screen: Size 6", Length 48
 (6) Were any formations sealed against pollution?
 _____ yes, _____ no.

CODED

If YES depth of formation _____
 Why _____
 Drillers Remarks: _____

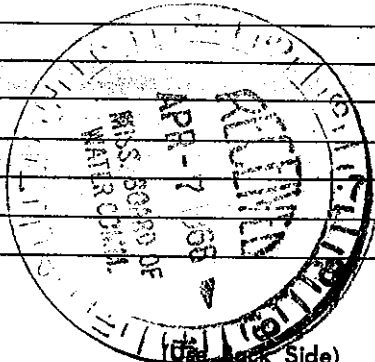

Well No.

Mail this copy to Board of Water Commissioners 429 Miss. St. Jackson, Miss.