

Bolivar
A 59
8-66

MISSISSIPPI BOARD OF WATER COMMISSIONERS

CODED

WATER WELL DRILLERS LOG CODED Bolivar

Date 8-16, 1966, Driller F. L. Lewis Franklin County Castana
(Name)


(1) Owner of Land: J. N. DUNN, JR.
(Name)
Alligator
(Address)
(2) Location: NE 1/4, NE 1/4, Sec. 36, T4R, W26
4 miles SW of Alligator
(distance) (direction) (Nearest Town)
(3) Topography: Flat
(Hilly) (Flat) (Level)
(4) Purpose of Well: Water
(Domestic Irrigation) (Municipal) (Industrial) (Other)

Description & Color of Materials Sand, Clay, Red Clay, Shell, etc.	Thick- ness Feet	Depth Feet
Clay		14
fine sand	19 1/2	33 1/2
clay	6 1/2	40
fine sand	6 1/2	46 1/2
med sand	6 1/2	53
sand & gravel	7 1/2	60 1/2
clay		131
CODED		

Information upon completion of well:

(1) Diameter 6 inches.
(2) Total Depth 126 feet.
(3) Water Level 14 feet below top of ground.
(4) Cased to 77' 4", Size 6"
(5) Screen: Size 6", Length 48"
(6) Were any formations sealed against pollution?
yes, no,

If YES depth of formation _____
Why _____
Drillers Remarks: _____

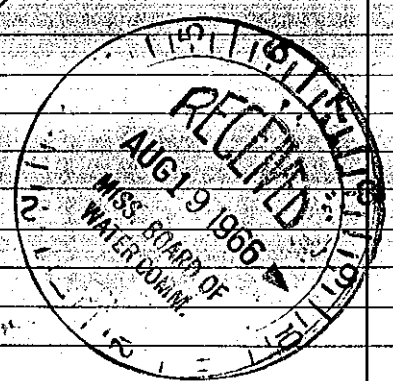

Well No. _____

(Use Back Side)

Mail this copy to Board of Water Commissioners 429 Miss. St. Jackson, Miss.