

CODED

CODED

Bolivar


F 60

2-67

MISSISSIPPI BOARD OF WATER COMMISSIONERS

416 North State Street
Jackson, Mississippi 39201

WATER WELL DRILLERS LOG

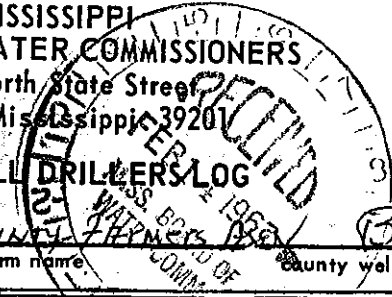

2-8 1967
date well completed

Five County Farmers Assn
firm name

Bolivar
county well located

LANDOWNER: JACK DODSON (KATAC PLANTATION) Clarksdale Miss (mailing address)	description of formations encountered	from	to
	TOPSOIL SAND		14'
	BROWN SAND	19 1/2'	33 1/2'
	Coarse Sand	13	46 1/2'
	Coarse Grey Sand	19 1/2'	66
	Sand + Shale	13	79
	Sand, trace clay (light)	6 1/2'	85 1/2'
	Sand, gravel + large rock	3 1/2'	118

WELL LOCATION:
NW NW
sec 27 T 26 N R 6 W
1 miles SE of Hillhouse
(distance) (direction) (nearest town)

WELL PURPOSE: IRRIGATION
(home, irrigation, municipal, industrial)

WELL COMPLETION DATA:

- (1) diameter (inches) 16
- (2) total depth (feet) 113
- (3) static water level (feet) 19.9 below top of ground.
- (4) casing 4" galv. 65' (material) (depth)
16" if telescope see back. (size)
- (5) screen 48" 65' (length) (depth to top)
16" steel (Doerr) (size) (material)
- (6) pump 6.3 3000 (HP) (yield gpm)
Chrysler (type power)
- (7) electric log NO (yes or no)
- (organization running log)
- (8) how well bottom plugged welded cap on bottom

CODED

DRILLERS REMARKS:

[Handwritten signature]