

BOLIVAR MISSISSIPPI BOARD OF WATER COMMISSIONERS

~~B-27~~ A62

WATER WELL DRILLERS LOG

8-5-65

CODED

BOLIVAR

Date: 8-5, 1965, Driller: Lee County Tennessee County Lee (Name)


(1) Owner of Land: DAVID CREIGHTON
 (Name)
Alligator Miss
 (Address)
 (2) Location: 3/4, 3/4, Sec. 36-26-6
36-26-5
5 miles S.W. of Alligator
 (distance) (direction) (Nearest Town)
 (3) Topography: Rolling
 (Hilly) (Flat) (Level)
 (4) Purpose of Well: Irrigation
 (Domestic Irrigation, Municipal, Industrial, Other)

Description & Color of Materials Sand, Clay, Red Clay, Shell, etc.	Thick- ness Feet	Depth Feet
TOP SOIL		14 1/2
CLAY + SAND	6 1/2	21
MEDIUM FINE SAND	6 1/2	27 1/2
" " "	6 1/2	34
" " "	6 1/2	40 1/2
MED SAND	6 1/2	47
" " "	6 1/2	53 1/2
SAND + GRAVEL	6 1/2	60
MED SAND + GRAVEL	45 1/2	105 1/2

Information upon completion of well:

(1) Diameter 6 inches.
 (2) Total Depth 101 feet.
 (3) Water Level 17' 11" feet below top of ground.
 (4) Cased to 52, Size 6
 (5) Screen: Size 6, Length 48
 (6) Were any formations sealed against pollution?
 _____ yes, no.

CODED

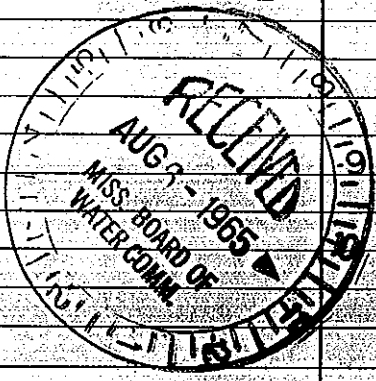

If YES depth of formation _____
 Why _____
 Drillers Remarks: _____

Well No.

(Use Back Side)

ail this copy to Board of Water Commissioners 429 Miss. St. Jackson, Miss.