Bolivar
GW-45662 /
Irrigation Equipment
ing completed: 03/28/2012

State Well Report Part 1 – Driller's Log Mississippi Department of Environmental Quality Office of Land and Water Resources P.O. Box 2309 Jackson, MS 39225 (601) 961-5210 (601) 961-5228 (fax)

For Office Use Only:			
Aquifer:	A 138		
Well #:			
L.S. Eleva	tion:		
E-log #:	······		

State Law requires that this report be prepared by the license holder responsible for the work and filed with the Department at the above address within 30 days of completion of drilling of the well or borehole.

Information on Well Owner	Well or Borehole Location		
(Landowner if borehole is not for a water well)			
Owner Name Charles Clark	Latitude: <u>34</u> ° <u>01</u> ' <u>09</u> " Longitude: <u>90</u> ° <u>46</u> ' <u>34</u> '		
Mailing Address: P.O. Box 604	Method of Lat/Long (check one): Conventional Survey,		
	🔲 USGS quad, 🛛 Hand-held GPS, 🔲 Survey-grade GPS		
Louisville Ms 39339	SE 1/4 SW 1/4 Sec 24 Twn 25N Rng 6W		
City State Zip code	Distance Direction Nearest Town		
Telephone No. () -	2 Miles Southwest of Duncan		
Well / Bo	orehole Data		
Date drilling started: 03/28/2012 Date drilling completed: 03/2	8/2012 Hole depth: 125 Hole diameter: 24"		
Location of the source of any surface water used for drilling: Surface			
Method of dosing and volume of Chlorine used in drilling and development			
Logs run (check all applicable): 🛛 No log run 🗌 Electric 🔲 Gamma Name of organization running log(s):			
Purpose of borehole (check one): X Water Well Geotechnical			
	· · · · · · · · · · · · · · · · · · ·		
Seismic Survey Other (a If drilling is not related to water well con	escribe)		
Purpose of Well (check one) Home Industrial Public Sup			
If flowing, method of flow regulation: Valve Other (des			
Static Water Level: feet above or below (check one) 🗋 lan	d 🗍 surface Date measured:		
Method of Measurement (check one) 🔲 steel tape 📋 electric tape [□ air line □ other:		
Well depth: <u>125</u> Well grouted to a depth of <u>10</u> feet Type of grout (check one): Neat Cement Bentonite Mix			
Casing length: 85 feet Casing diameter: 16	inches Type of casing: PVC		
Screen length: 40 feet Screen diameter: 16	inches Type of screen: PVC		
Screen slot size: .050 inches Setting depth: From	86 feet to 125 feet		
Type of completion (check all applicable): 🛛 Gravel packed 🗌 U	nderreamed 🗌 Telescoped 🗌 Open hole 🗍 Natural Development		
Other (describe): Circle S Irrigation will set pump			
Top of lap pipe or reduction in casing: feet. If	telescoped or more than one screen, describe on next page		
	Form: OLWR-SWR-1A (04/08)		

RECEIVED

APR 1 0 2012

BY: OLWR

The sketch below only required for water wells

If well telescopes, show depths on sketch. Ground level Description of formations encountered must be provided for all wells and boreholes, unless specifically exempted by regulations

A		3.	Z
---	--	----	---

BY: OLWR

Description of Formations Encountered	From (depth)	To (depth)
Clay	Ground level	15
Brown Sand	16	35
Fine Sand	36	55
Medium Sand & Gravel	56	85
Course Sand & Gravel	86	125

If more than one screen, show location of each on sketch


aid in	ayout and include the follow locating the well; 3) any ro orth arrow.	ving: 1) the well location; 2 ads, power lines, or other ite) any permanent structures on ems that may aid in locating th	the property that may e property and the well;
Landowner Name:	Charles Clark			
I certify that the well/bo Mississippi Department laws. Patrick Chism Print Name of Responsible Lice	rehole was drilled, constructe of Environmental Quality an 0695	ed, and completed in accordan d the Mississippi Department 04/02/2012 Date	nce with all applicable requiren t of Health regulations, if applic	Form: OLWR-SWR-1A (04/08) tents of the able, and state
		Date	Signature of Licensee	RECEIVED
Form provided by Forms On	-A-Disk · 214-340-9429 · FormsOn	ADisk.com		APR 1 0 2012

•	STATE W	ELL REPORT	
County: BOLIVAZ	1 :	Part 2	E. Off. H. O.I.
Permit #: Gw - 45662	Pump Installer's Completion Report Mississippi Department of Environmental Quality		For Office Use Only: Aquifer:
Driller: JRRSGATION EQUEMENT		1 and Water Resources 0. Box 2309	
Date completed:	Jackso	on, MS 39225	Well #:
<u>Copy information from block on Part 1</u>		1)961-5210 961-5228 (fax)	Elevation:
This part of the report must be completed	by a licensed water well	l contractor or a licensed pump i	nstaller. A copy of Part 1 of the
report must be attached and both parts fil Well Owner Informat			<i>ays of well completion.</i> I Location
CHARLES OLD			
Owner Name: <u>CHARLES</u> CLA Mailing Address: <u>P.O. BOX (JC</u>	<u>2K</u>	Latitude:	_Longitude:
Mailing Address: NO. BOX 6)4	_	ne): Conventional Survey,
		USGS quad, Hand-held	GPS, Survey-grade GPS
City State	<u>39339</u> Zip Code	¼¼ Sec_ ∂ .	4 T25NR 6W
		Distance Direction	Nearest Town
Telephone No. (202) 803 - 07/0		Mileso	f
Ритр Туре	······································	Pov	wer Type
Circle one		Ci	rcle one
Air Lift Jet	Submersible	Diesel Engine Gasolin	e Engine Natural Gas
Bucket Piston	Turbine	Electric Motor Hand	Tractor PTO
Centrifugal Rotary	Flowing Well	Windmill Other (specify):
Other (specify):		Horse Power Rating of Motor:	60
Date Pump Installed: <u>4-27-1</u>	2	Setting Depth:	70 feet
Rated Pump Capacity: <u>Z200</u>	Gallons Per Minute	Number of Stages:	2
Pump Test Data	· · · · · · · · · · · · · · · · · · ·	Method of Mes	asuring Water Level
Date Well Tested:		Ci	rcle one
Static Water Level (A):Feet Below Land Surface		Air Line Electric Meas	
Pumping Water Level (B):Feet E	Below Land Surface	Other (specify):	
Drawdown [(B) - (A)]:Feet H	Below Land Surface	For flowing well, measured she	ut in head:feet
est Pumping Rate:	Gallons Per Minute	Well yielded	_GPM with a drawdown of
Duration of Pump Test (minimum 4 hours):	hours	feet after	hours of pumping
			Dr. A.
HEREBY CERTIFY that the above statemed DAVEN P. HOLT	ents are true to the best of $0 - 752P$	of my knowledge.	ff ff ff
Print Name of Pump Installer and License No		Signature of Pump Ins	taller REC

•

MAY	2 9 2012	
BY:	OLWR	

A138

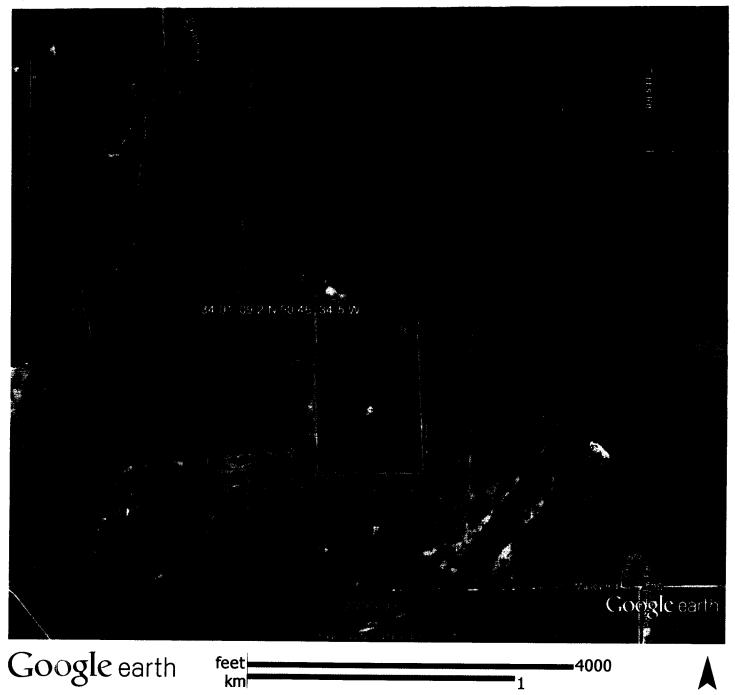

RECEIVED

APR 1 0 2012 BY: OLWR STATE OF MISSISSIPPI Department of Environmental Quality Office of Land and Water Resources P. O. Box 2309 Jackson, Mississippi 39225

A138

PERMIT

TO DIVERT OR WITHDRAW FOR BENEFICIAL USE THE PUBLIC WATERS

This permit is issued to the landowner named below in accordance with the provisions of the Mississippi Wator Laws, Mississippi Code Sections 51-3-1, et seq.(1972, as amended), and the regulations and standards as promulgated thercunder. Whether or not specifically named in this permit or in the applications for this permit, anyone using water from the diversion/withdrawal point described below shall do so in compliance with the provisions of this permit. Neither this permit, nor any authority conferred hereby, may be sold, conveyed, encumbered, assigned, or otherwise aliened, for any period of time or under any conditions whatsoever. This permit may not be modified, transferred or revoked without prior action by the Permit Board. Any attempts to modify, transfer or revoke this permit, or to take any other action on this permit, shall be invalid and unenforceable and may result in immediate revocation or suspension of this permit. The holder of this permit shall at all times be responsible for adherence to the terms and conditions of this permit. No agreement between the permit holder and any other party shall affect the obligations and liabilities of the permit holder. Water use under this permit is allowed only when the streamflow, lake level elevation, or static groundwater level (whichever, if any, is applicable) is above the established minimum, pursuant to Mississippi Code Section 51-3-7. Authorization is hereby granted to divert/withdraw water for the beneficial use designated herein, and for no other purpose, subject to

Section: 24

Quad: ROUND LAKE equivalent to .1526 Million Gallons/Day

Permit Number: MS-GW-45662

Landowner Name: CLARK, CHARLES Landowner Address: PO BOX 604 LOUISVILLE MS 39339

Source Of Water: MISSISSIPPI RIVER VALLEY ALLUVIAL AQUIFER

Beneficial Use: IRRIGATION

Diversion/Withdrawal Location: SE 1/4 of the SW 1/4

County: BOLIVAR Maximum Volume: 171 Acre-Feet/Year Maximum Rate: 1800 Gallons/Minute

Applicant Name: CLARK, CHARLES Applicant Address; PO BOX 604 LOUISVILLE

Date Permit Issued: 11/30/2011 Date Permit Expires: 11/30/2016 **Date Permit Modified:**

Date Permit Re-issued:

This permit shall be deemed null and void if construction has not begun within one (1) year of permit issue date SPECIAL TERMS AND CONDITIONS: SEE ATTACHMENT 1, WHICH IS HEREBY DECLARED TO BE PART OF THIS PERICT.

MS

39339

TERMS AND CONDITIONS 2:

James L. Crawford Office Director

Township:25N

Range: 06w

RECEIVED APR 1 0 2012 BY: OLWR