

County: Bolivar
 Permit #: GW-47541
 Driller: TEDDY COATS
 Date drilling completed: 9-14-13

State Well Report
Part 1 - Driller's Log
 Mississippi Department of Environmental Quality
 Office of Land and Water Resources
 P.O. Box 2309
 Jackson, MS 39225
 (601)961- 5210
 (601)961- 5228 (fax)

For Office Use Only:
 Aquifer: A156
 Well #: _____
 L. S. Elevation: _____
 E-log #: _____

State Law requires that this report be prepared by the license holder responsible for the work and filed with the Department at the above address within 30 days of completion of drilling of the well or borehole.

Information on Well Owner (Landowner if borehole is not for a water well)	Well or Borehole Location
Owner Name: <u>Watts Planting Co</u>	Latitude: <u>34° 06' 05"</u> Longitude: <u>90° 50' 36"</u>
Mailing Address: <u>P.O. Box 429</u>	Method of Lat/Long (circle one): Conventional Survey, _____
<u>Marksville MS 38644</u>	USGS quad, Hand-held GPS, Survey-grade GPS
City State Zip Code	<u>SE 1/4 NW 1/4 Sec 29 Twn 26N Rng 06W</u>
Telephone No. <u>(662) 902-8940</u>	Distance Direction Nearest Town
	<u>5 Miles S of Rankin</u>

Well / Borehole Data

Date drilling started: 9-14-13 Date drilling completed: 9-14-13 Hole depth: 120 Hole diameter: 28.0

Location of the source of any surface water used for drilling: nearest well

Method of dosing and volume of Chlorine used in drilling and development: _____

Logs run (circle all applicable): (No log run) Electric Gamma Ray Density Sonic Neutron Other: _____

Name of organization running log(s): _____

Purpose of borehole (check one): Water Well Geotechnical/Geological Investigation _____ Ground Source Heat Pump _____

Seismic Survey _____ Other (describe) _____

If drilling is not related to water well construction, skip the remainder of this block

Purpose of Well (check one): Home _____ Industrial _____ Public Supply _____ Irrigation Fish Culture _____ Other: _____

If a flowing well, method of flow regulation: Valve _____ Other (describe) _____

Static Water Level: 5 feet above or below (circle one) land surface Date measured: 9-14-13

Method of Measurement (circle one) steel tape electric tape air line other: _____

Well depth: 120 Well grouted to a depth of 10 feet Type of grout (circle one): Neat Cement Bentonite Mix

Casing length: 80 feet Casing diameter: 16 inches Type of casing: PVC

Screen length: 40 feet Screen diameter: 16 inches Type of screen: PVC

Screen slot size: 0.50 inches Setting depth: From 80 feet to 120 feet

Type of completion (circle all applicable): Gravel packed Underreamed Telescoped Open hole Natural Development

Other (describe): _____

Top of lap pipe or reduction in casing: _____ feet. ***If telescoped or more than one screen, describe on next page***


RECEIVED
 SEP 25 2013
 BY: [Signature]

A156

The sketch below only required for water wells

If well telescopes, show depths on sketch.

Ground Level →

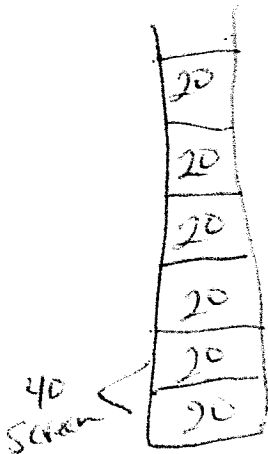

Description of formations encountered must be provided for all wells and boreholes, unless specifically exempted by regulations

Description of Formations Encountered	From (depth)	To (depth)
Coarse	Ground Level	20
Coarse	20	40
Sand	40	60
Coarse	60	80
Gravel	80	100
Gravel	100	120

If more than one screen, show location of each on sketch

Sketch the property layout and include the following: 1) the well location; 2) any permanent structures on the property that may aid in locating the well; 3) any roads, power lines, or other items that may aid in locating the property and the well; 4) a north arrow.

Landowner Name: Watts Planting Co

Form: OLWR-SWR-1A (04/08)

I certify that the well/borehole was drilled, constructed, and completed in accordance with all applicable requirements of the Mississippi Department of Environmental Quality and the Mississippi Department of Health regulations, if applicable, and state laws.

Print Name of Responsible Licensee and License No. JERRY COALSON/5318 Date 9-14-13

Signature of Licensee Jerry Coalson RECEIVED SEP 25 2013

BY: OLWR

STATE WELL REPORT

Part 2

Pump Installer's Completion Report
 Mississippi Department of Environmental Quality
 Office of Land and Water Resources
 P.O. Box 2309
 Jackson, MS 39225-2309
 (601)961-5210
 (601) 360-0535 (fax)

For Office Use Only:

Well #: A156
 Aquifer: _____

County: Bolivar
 Permit #: CU-47541
 Driller: Teckly Coats
 Date completed: 9-14-13
Copy information from block on Part 1

This part of the report must be completed by a licensed water well contractor or a licensed pump installer. A copy of Part 1 of the report must be attached and both parts filed with the Department at the above address within 30 days of well completion.

Well Owner Information	Well Location
Owner Name: <u>Watts Drilling Comp</u>	Latitude: <u>34-66-05</u> Longitude: <u>90-50-36</u>
Mailing Address: <u>Po Box 429</u>	Method of Lat/Long (check one): Conventional Survey _____, USGS quad _____, Hand-held GPS <input checked="" type="checkbox"/> , Survey-grade GPS _____
<u>Clarksdale</u> <u>MS</u> <u>38604</u>	<u>SE 1/4 NW 1/4, Sec 29 T 26N R 12W</u>
City State Zip Code	<u>5</u> Miles <u>S</u> of <u>Rem Lap</u>
Telephone No. (____) _____	(Distance) (Direction) (Nearest Town)

Pump Type (circle one)

Submersible: Turbine Air Lift Centrifugal Flowing Well Jet Piston Rotary Other (describe): _____

Date Pump Installed: 9-14-13 Rated Pump Capacity: 2200 Gallons Per Minute

Is This Pump (circle one): New Repaired Replacement

Power Type (circle one)

Electric: Diesel Gasoline Natural Gas Tractor PTO Windmill Other (describe): _____

Horse Power Rating of Motor: 60 Setting Depth: 60 feet Number of Stages: 1

Pump Test Data for Non Flowing Well

Date Well Tested: 9-14-13 Duration of Pump Test (minimum 4 hours): 8 hours

Static Water Level (A): 8 Feet Below Land Surface Pumping Water Level (B): 23 Feet Below Land Surface

Drawdown [(B) - (A)]: 15 Feet Below Land Surface Test Pumping Rate: 2200 Gallons Per Minute

Method of measurement (circle one): Steel tape Electric tape Air line Other (describe): _____

Pump Test Data for Flowing Well

Measured shut in head: _____ feet.

Well yielded 2200 GPM with a drawdown of 15 feet after 8 hours of pumping

Meter Installation

Meter Manufacturer: _____ Meter Serial Number: _____

Meter Model Number/Name: _____ Type of Meter: _____

Totalizer Register Unit and Multiplier Factor (AF x .001, gal x 1000, etc): _____

Installation Date: _____ Meter installed by: _____

Is This Meter (circle one): New Repaired Replacement

Important: By submitting the above information you are certifying that this meter was installed to manufacturer standards. For agricultural wells, a list of approved meters is on the MDEQ website.


I HEREBY CERTIFY that the above statements are true to the best of my knowledge.

Teckly Coats 5318 9-14-13 [Signature]
 Print Name of Pump Installer and License No. (if applicable) Date Signature of Pump Installer
 Form: OLWR-SWR-1B (4/13)

RECEIVED
 SEP 25 2013
 BY [Signature]

RECEIVED
SEP 25 2013
BY: OLWH

© 2013 Google

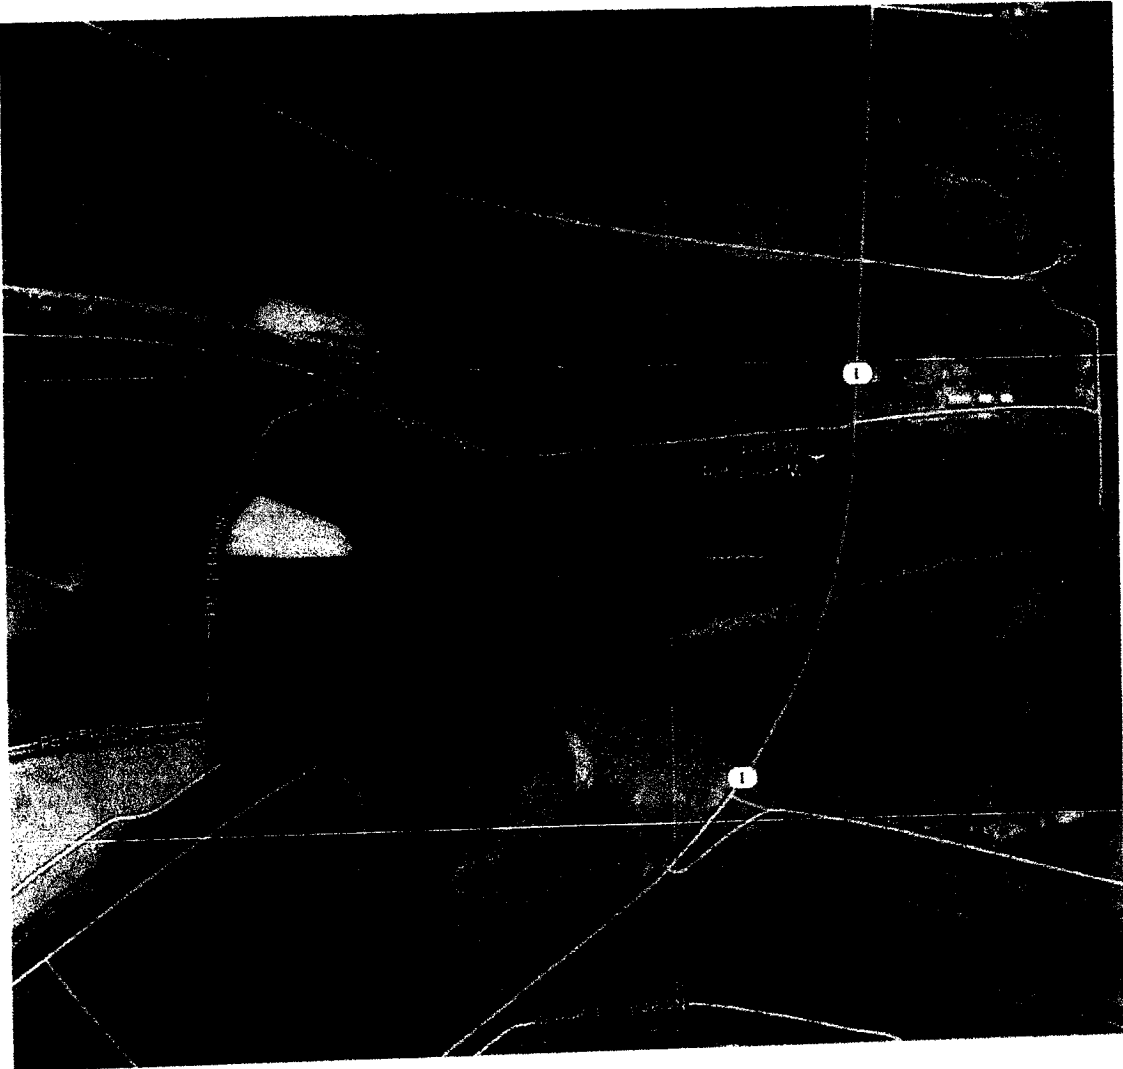

Google

To see all the details that are visible on the screen, use the "Print" link next to the map.

#156

80
Aves



Dean A. Pennington, PhD
Executive Director

P. O. Box 129
Stoneville, MS 38776
Tel.: (662) 686-7712
Fax: (662) 686-9078
www.ymd.org

AISC

Yazoo Mississippi Delta Joint Water Management District

July 8, 2013

WATTS PLANTING COMPANY
P. O. BOX 429
CLARKSDALE, MS 38614

RE: Well Construction/Authorization to drill

Permit No: GW-47541

DEAR WATTS PLANTING COMPANY:

This authorization letter is for the construction of a new well that is to be drilled in the Mississippi River Valley Alluvial Aquifer. Your application has been received and is currently being processed.

Location: SE1/4 of the NW1/4 Section 29 Township 26N Range 06W County BOLIVAR
Latitude: 34 06 05 Longitude: 90 50 36

A copy of this notice or a water use permit **must be** attached to the State Well Report submitted by your driller. This report is a requirement of the State Well Drillers Regulation. A copy of this report **must be** mail or faxed to YMD Joint Water Management District.

All applications must meet the **Mississippi Department of Environmental Quality** rules and regulations. If no adverse comments are received the application will be presented to the Mississippi Department of Environmental Quality State Permit Board for approval.

If you have any questions please call YMD at 662/686-7712.

Sincerely,

Dillard Melton Jr.
Permitting Director

RECEIVED

SEP 25 2013

BY: [Signature]