

STATE WELL REPORT

Part I

Driller's Log

Mississippi Department of Environmental Quality
Office of Land and Water Resources

P.O. Box 2309
Jackson, MS 39225-2309

(601)961-5210
(601)360-0535 (fax)

For Office Use Only:

Well #: A 162

Aquifer: _____

F-Log #: _____

County: Bolivar
 Permit #: GW-47697
 Driller: Richard Foster
 Date drilling completed: 5-22-14

State Law requires that this report be prepared by the license holder responsible for the work and filed with the Department at the above address within 30 days of completion of drilling of the well or borehole.

Well Owner Information (Landowner if borehole is not for a water well)	Well or Borehole Location
Owner Name: <u>Alkudale Planting Co.</u>	Latitude: <u>N34° 2' 32.97"</u> Longitude: <u>W90° 49' 1.48"</u>
Mailing Address: <u>P.O. Box 26</u>	Method of Lat/Long (check one): Conventional Survey _____
<u>Shelby</u> <u>MS</u> <u>38720</u>	USGS quad _____ Hand-held GPS <input checked="" type="checkbox"/> Survey-grade GPS _____
City State Zip Code	<u>SW 1/4 NW 1/4, Sec 15, T05N R06W</u>
Telephone No. (<u>662</u>) <u>221-0146</u>	<u>2.17</u> Miles <u>East</u> of <u>Round Lake</u>
	(Distance) (Direction) (Nearest Town)

Well / Borehole Data

Date drilling started: 5-22-14 Date drilling completed: 5-22-14 Hole depth: 125' Hole diameter: 22"

Location of the source of any surface water used for drilling: near by well

Method of dosing and volume of Chlorine used in drilling and development: _____

Logs run (circle all applicable): ~~No log run~~ Electric Gamma Ray Density Sonic Neutron Other: _____

Name of organization running log(s): _____

Purpose of borehole (circle one): ~~Water well~~ Geotechnical/Geological Investigation Ground Source Heat Pump
 Seismic Survey Other (describe) _____

If drilling is not related to water well construction, skip the remainder of this block

Purpose of Well (circle all applicable): Home Industrial Public Supply ~~Agitation~~ Fish Culture

Other (describe): _____

If a flowing well, method of flow regulation: Valve _____ Other (describe) _____

Static Water Level: 23 feet (above or ~~below~~ land surface Date measured: 5-23-14
 (circle one)

Method of measurement (circle one): Steel tape ~~Electric tape~~ Air line Other (describe): _____

Well depth: 125' Well grouted to a depth of: 10 feet Type of grout (circle one): ~~Neat Cement~~ Bentonite Mix

Casing length: 85 feet Casing diameter: 10 inches Type of casing: PVC

Screen length: 40 feet Screen diameter: 10 inches Type of screen: PVC

Screen slot size: .050 inches Setting depth: From 85 feet to 125 feet

Type of completion (circle all applicable): ~~Gravel packed~~ Underreamed Open hole Natural Development

Other (describe): _____

Top of lap pipe or reduction in casing: N/A feet


If telescoped or more than one screen, describe on next page

County Bolivar
Permit #: GW-47697

For Office Use Only:
Well #: A 162

The sketch below only required for water wells


If well telescopes, show depths on sketch.

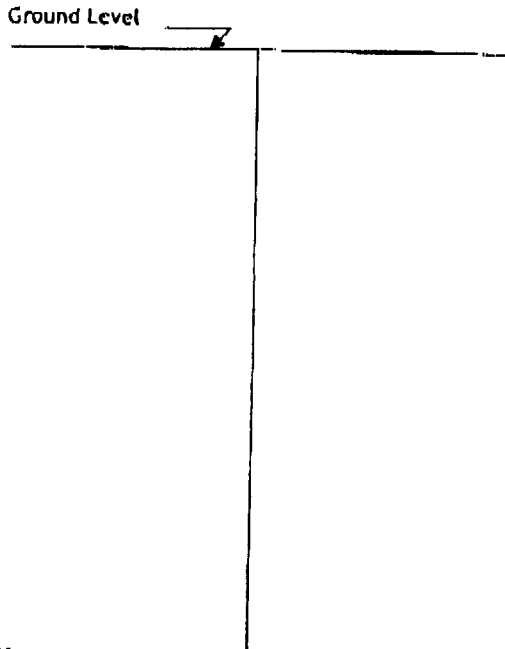

Description of formations encountered must be provided for all wells and boreholes, unless specifically exempted by regulations

Description of Formations Encountered	From (depth)	To (depth)
Clay	Ground level	3
Fine Sand	3	12
Clay	12	21
Fine Sand	21	39
Medium Sand	39	58
Medium/Coarse Sand	58	
& Pea Gravel		79
Coarse Sand & Gravel	79	125

If more than one screen, show location of each on sketch

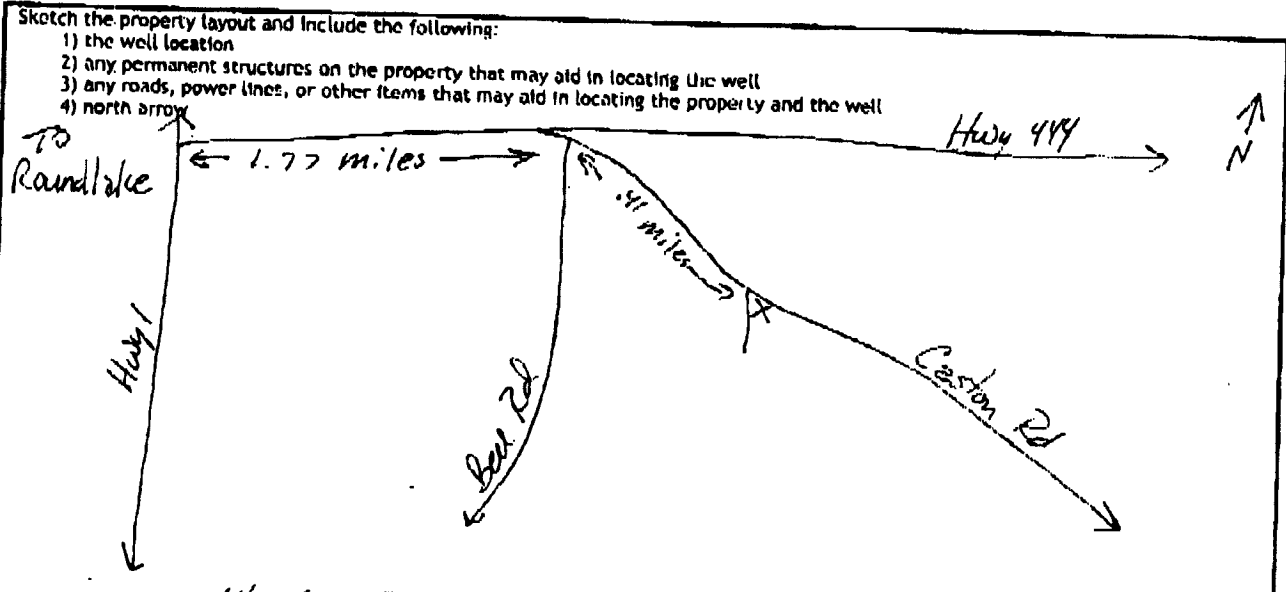

Landowner Name: Allendale Planting Co.

I HEREBY CERTIFY that the well/borehole was drilled, constructed, and completed in accordance with all applicable requirements of the Mississippi Department of Environmental Quality and the Mississippi Department of Health regulations, if applicable, and state laws.

Print Name of Responsible Licensee and License No. Clayton Miller 0-703 5-23-14 Date
Signature of Licensee Clayton Miller

STATE WELL REPORT

Part 2

Pump Installer's Completion Report
 Mississippi Department of Environmental Quality
 Office of Land and Water Resources
 P.O. Box 2309
 Jackson, MS 39225-2309
 (601)961-5210
 (601) 360-0535 (fax)

For Office Use Only:

Well #: A 162

Aquifer: _____

County: Bolivar
 Permit #: GW-47697
 Driller: Jeff White
 Date completed: 5-23-14
Copy information from block on Part 1

This part of the report must be completed by a licensed water well contractor or a licensed pump installer. A copy of Part 1 of the report must be attached and both parts filed with the Department at the above address within 30 days of well completion.

Well Owner Information			Well Location	
Owner Name:	<u>Alkendale Planting Co</u>		Latitude:	<u>N34° 2' 32.97"</u>
Mailing Address:	<u>P.O. Box 26</u>		Longitude:	<u>W90° 49' 1.48"</u>
City:	State:	Zip Code:	Method of Lat/Long (check one): Conventional Survey _____	
<u>Shelby</u>	<u>MS</u>	<u>38920</u>	USGS quad _____, Hand-held GPS <u>X</u> , Survey-grade GPS _____	
Telephone No. (<u>662</u>) <u>721-0146</u>			<u>Sec 15 T25N R06W</u>	
			<u>2.17</u> Miles <u>East</u> of <u>Round Lake</u>	
			(Distance) (Direction) (Nearest Town)	

Pump Type (circle one)

Submersible Turbine Air Lift Centrifugal Flowing Well Jet Piston Rotary Other (describe): _____

Date Pump Installed: 5-23-14 Rated Pump Capacity: _____ Gallons Per Minute

Is This Pump (circle one): New Repaired Replacement

Power Type (circle one)

Electric Diesel Gasoline Natural Gas Tractor PTO Windmill Other (describe): _____

Horse Power Rating of Motor: _____ Setting Depth: _____ feet Number of Stages: _____

Pump Test Data for Non Flowing Well

Date Well Tested: NOT TESTED Duration of Pump Test (minimum 4 hours): N/A hours

Static Water Level (A): 23 Feet Below Land Surface Pumping Water Level (B): N/A Feet Below Land Surface

Drawdown ((B) - (A)): N/A Feet Below Land Surface Test Pumping Rate: N/A Gallons Per Minute

Method of measurement (circle one): Steel tape Electric tape Air line Other (describe): _____

Pump Test Data for Flowing Well

Measured shut in head: _____ feet.

Well yielded _____ GPM with a drawdown of _____ feet after _____ hours of pumping

Meter Installation

Meter Manufacturer: _____ Meter Serial Number: _____

Meter Model Number/Name: _____ Type of Meter: _____

Totalizer Register Unit and Multiplier Factor (AF x .001, gal x 1000, etc): _____

Installation Date: _____ Meter installed by: _____

Is This Meter (circle one): New Repaired Replacement

Important: By submitting the above information you are certifying that this meter was installed to manufacturer standards. For agricultural wells, a list of approved meters is on the MDEQ website.

I HEREBY CERTIFY that the above statements are true to the best of my knowledge.

Clayton Miller 0-703 5-23-14 Clayton Miller
 Print Name of Pump Installer and License No. (if applicable) Date Signature of Pump Installer