

County: Bolivar
 Permit #: 6049893 ✓
 Driller: TEDDY COATS
 Date drilling completed: 7/10/17

State Well Report
Part 1 - Driller's Log
 Mississippi Department of Environmental Quality
 Office of Land and Water Resources
 P.O. Box 2309
 Jackson, MS 39225
 (601)961-5210
 (601)961-5228 (fax)

For Office Use Only:
 Aquifer: _____
 Well #: A172
 L. S. Elevation: _____
 E-log #: _____

State Law requires that this report be prepared by the license holder responsible for the work and filed with the Department at the above address within 30 days of completion of drilling of the well or borehole.

Information on Well Owner (Landowner if borehole is not for a water well)	Well or Borehole Location
Owner Name <u>John Watts Trust</u>	Latitude: <u>34° 5' 48" N</u> Longitude: <u>90° 48' 57" W</u>
Mailing Address: _____ <u>P.O. Box 429</u>	Method of Lat/Long (circle one): Conventional Survey, _____
<u>Clarksdale</u> <u>MS</u> <u>38614</u>	USGS quad, <u>Hand-held GPS</u> , Survey-grade GPS _____ <u>NW 1/4 SW 1/4 Sec 27 Twn 26N Rng 06W</u>
City State Zip Code	Distance Direction Nearest Town <u>4</u> Miles <u>S</u> of <u>Rena Lure</u>
Telephone No. () _____	

Well / Borehole Data

Date drilling started: 7/10/17 Date drilling completed: 7/10/17 Hole depth: 120 Hole diameter: 28

Location of the source of any surface water used for drilling: nearest well
 Method of dosing and volume of Chlorine used in drilling and development: _____

Logs run (circle all applicable): No log run Electric Gamma Ray Density Sonic Neutron Other: _____
 Name of organization running log(s): _____

Purpose of borehole (check one): Water Well Geotechnical/Geological Investigation _____ Ground Source Heat Pump _____
 Seismic Survey _____ Other (describe) _____

If drilling is not related to water well construction, skip the remainder of this block

Purpose of Well (check one): Home _____ Industrial _____ Public Supply _____ Irrigation Fish Culture _____ Other: _____

If a flowing well, method of flow regulation: Valve _____ Other (describe) _____

Static Water Level: 20 feet above below (circle one) land surface Date measured: 7/10/17

Method of Measurement (circle one) steel tape electric tape air line other: _____

Well depth: 120 Well grouted to a depth of 10 feet Type of grout (circle one): Neat Cement Bentonite Mix

Casing length: 80 feet Casing diameter: 16 inches Type of casing: PVC

Screen length: 40 feet Screen diameter: 16 inches Type of screen: PVC

Screen slot size: 050 inches Setting depth: From 80 feet to 70 120 feet

Type of completion (circle all applicable): Gravel packed Underreamed Telescoped Open hole Natural Development
 Other (describe): _____

Top of lap pipe or reduction in casing: _____ feet. *If telescoped or more than one screen, describe on next page*

Form: OLWR-SWR1A (04/08)

RECEIVED
 AUG 14 2017
 BY OLWR

STATE WELL REPORT

Part 2

Pump Installer's Completion Report
 Mississippi Department of Environmental Quality
 Office of Land and Water Resources
 P.O. Box 2309
 Jackson, MS 39225
 (601)961-5210
 (601)961-5228 (fax)

County: Bolivar
 Permit #: 6W 49893
 Driller: TEDDY Coats
 Date completed: 7/10/17
Copy information from block on Part 1

For Office Use Only:

Aquifer: _____
 Well #: A172
 Elevation: _____

This part of the report must be completed by a licensed water well contractor or a licensed pump installer. A copy of Part 1 of the report must be attached and both parts filed with the Department at the above address within 30 days of well completion.

Well Owner Information	Well Location
Owner Name: <u>John Watts Trust</u>	Latitude: <u>34° 48' N</u> Longitude: <u>90° 48' 57" W</u>
Mailing Address: _____ <u>P.O. Box 429</u>	Method of Lat/Long (check one): Conventional Survey _____ USGS quad _____, Hand-held GPS <input checked="" type="checkbox"/> Survey-grade GPS _____
<u>Clarksdale</u> MS, <u>38614</u>	<u>NW 1/4 SW 1/4 Sec 27 T26N R 06W</u>
City State Zip Code	Distance Direction Nearest Town <u>4</u> Miles <u>S</u> of <u>Rena Lake</u>
Telephone No. () _____	

Pump Type Circle one	Power Type Circle one
Air Lift Jet Submersible	<u>Diesel Engine</u> Gasoline Engine Natural Gas
Bucket Piston <u>Turbine</u>	<u>Electric Motor</u> Hand Tractor PTO
Centrifugal Rotary Flowing Well	Windmill Other (specify): _____
Other (specify): _____	Horse Power Rating of Motor: <u>60 HP</u>
Date Pump Installed: <u>7/10/17</u>	Setting Depth: <u>70</u> feet
Rated Pump Capacity: <u>2500</u> Gallons Per Minute	Number of Stages: <u>2-Stage 12</u>

Pump Test Data	Method of Measuring Water Level Circle one
Date Well Tested: <u>7/10/17</u>	Air Line <u>Electric Measuring Line</u> Steel Tape
Static Water Level (A): <u>25</u> Feet Below Land Surface	Other (specify): _____
Pumping Water Level (B): <u>30</u> Feet Below Land Surface	For flowing well, measured shut in head: _____ feet
Drawdown [(B) - (A)]: <u>10</u> Feet Below Land Surface	Well yielded <u>2000</u> GPM with a drawdown of
Test Pumping Rate: <u>2500</u> Gallons Per Minute	<u>10</u> feet after <u>4</u> hours of pumping
Duration of Pump Test (minimum 4 hours): <u>4</u> hours	

I HEREBY CERTIFY that the above statements are true to the best of my knowledge.


TEDDY Coats #5218 Teddy Coats
 Print Name of Pump Installer and License No. (if applicable) Signature of Pump Installer

RECEIVED
 AUG 17 2017
 BY OLWR

A17a

Google Maps

34°05'48.0"N 90°
48'57.0"W

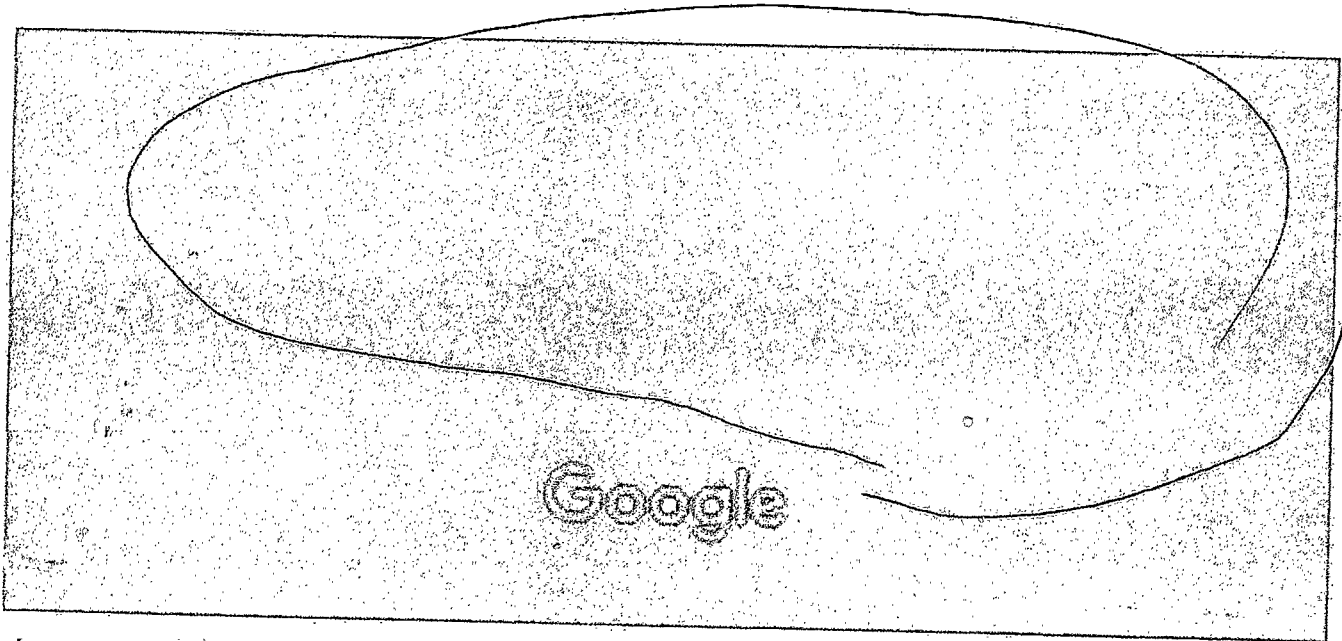

Imagery ©2017 DigitalGlobe, State of Arkansas, 200 ft

USDA Farm Service Agency, Map data ©2017

Google

Bolivar County

RECEIVED
AUG 17 2017
BY OLWR