

**BOLIVAR** MISSISSIPPI BOARD OF WATER COMMISSIONERS


A-100

**6-4-65 WATER WELL DRILLERS LOG** *6/10/65* *36-20A*

Date: June 4, 1965, Driller: Layne-Central Company County Bolivar

(Name)

	Description & Color of Materials Sand, Clay, Red Clay, Shell, etc.	Thick- ness Feet	Depth Feet
(1) Owner of Land: <u>W. A. Welshans, Jr.</u> (Name) <u>Rosedale, Mississippi</u> (Address)	Clay	11	11
	Sandy clay	18	29
	Fine sand	18	47
(2) Location: <u>1/4, 1/4, Sec. T. R.</u> <u>6 miles northeast of Perthshire</u> (distance) (direction) (Nearest Town)	Coarse sand	18	65
	Coarse sand & gravel	103	168
	Sand	81	249
(3) Topography: <u>flat</u> (Hilly) (Flat) (Level)	Clay	7	256
	Sand with small clay strks.	52	308
(4) Purpose of Well: <u>domestic</u> (Domestic Irrigation Municipal, Industrial, Other)	Clay & sand strks.	12	320
	Sand with clay strks.	90	410
	Sand	52	462
Information upon completion of well: (1) Diameter <u>4x3</u> inches. (2) Total Depth <u>823</u> feet. (3) Water Level <u>19' 9"</u> feet below top of ground. (4) Cased to <u>660' 1"</u> Size <u>3"</u> <u>126' 3"</u> Size <u>4"</u> <u>10"</u> of <u>4x3</u> swage (5) Screen: Size <u>3"</u> Length <u>30' 4"</u> <u>5' 9"</u> of <u>3"</u> B.P.V. (6) Were any formations sealed against pollution? <u>yes</u> yes, <u>no</u> no. If YES depth of formation <u>Packer</u> above the screen, and B.P.V. Why _____ Drillers Remarks: _____	Sand & clay	7	469
	Clay & sand strks.	32	501
	Sand	50	551
	Clay	1	552
	Hard sand	33	585
	Hard sand & clay	5	590
	Hard sand	64	654
	Clay & sandy clay	44	698
	Sand	125	823
	Clay	10	833

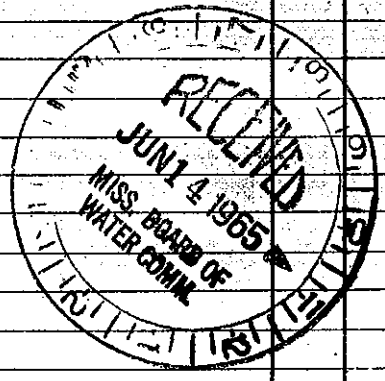

Well No.

(Use Back Side)

Mail this copy to Board of Water Commissioners 429 Miss. St. Jackson, Miss.