

MISSISSIPPI DEPARTMENT OF NATURAL RESOURCES  
Bureau of Land and Water Resources

Southport Mall  
P.O. Box 10631

Jackson, Mississippi 39209

WATER WELL DRILLERS LOG

**BOLIVAR**  
A-1004  
7-24-81

7-24 1981 date well completed  
Butane Gas Co. firm name  
Bolivar county well located

| LANDOWNER:                   | description of formations encountered | from | to  |
|------------------------------|---------------------------------------|------|-----|
| John Summers                 | sand                                  | 0    | 60  |
| Deason Mo. (mailing address) | sand & gravel                         | 60   | 100 |
|                              | gravel                                | 100  | 155 |
|                              | clay & sand                           | 155  | 320 |
|                              | shale                                 | 320  | 425 |
|                              | sand                                  | 425  | 470 |

LANDOWNER:

description of formations encountered

from to


WELL LOCATION:

sec 18 T 25 N R 6 E  
1.5 miles N of Deason  
(distance) (direction) (nearest town)

WELL PURPOSE: Domestic  
(home, irrigation, municipal, industrial)

WELL COMPLETION DATA:

- (1) diameter (inches) 4" x 2"
- (2) total depth (feet) 470
- (3) static water level (feet) 30' below top of ground.
- (4) casing galvanized 450 (material) (depth)  
4 1/2" if telescope see back. (size)
- (5) screen 20' 450 (length) (depth to top)  
2" stainless steel (size) (material)
- (6) pump 1 (HP) 15 (yield gpm)  
Electric (type power)
- (7) electric log (yes or no)  
(organization running log)
- (8) how well bottom plugged  
back wash valve

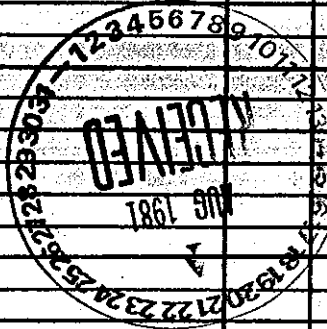

DRILLERS REMARKS: