

BOLIVAR
B-29

MISSISSIPPI BOARD OF WATER COMMISSIONERS

12-19-56 WATER WELL DRILLERS LOG


11/15/65
CODED

Date: Dec. 19, 19 56, Driller: Layne-Central Company County Bolivar

(Name)

(1) Owner of Land: <u>Billy R. Butler</u> (Name)	Description & Color of Materials Sand, Clay, Red Clay, Shell, etc.	Thick- ness Feet	Depth Feet
<u>Alligator, Mississippi</u> (Address)	<u>Clay</u>	<u>19</u>	<u>19</u>
(2) Location: <u>1/4, 1/4, Sec. 5, T25R5</u>	<u>Fine sand</u>	<u>9</u>	<u>28</u>
<u>5</u> miles <u>south</u> of <u>Alligator</u> (distance) (direction) (Nearest Town)	<u>Coarse sand</u>	<u>24</u>	<u>52</u>
(3) Topography: <u>flat</u> (Hilly) (Flat) (Level)	<u>Coarse sand, pea gravel</u>	<u>64</u>	<u>116</u>
(4) Purpose of Well: <u>irrigation</u> (Domestic Irrigation Municipal, Industrial, Other)	<u>Clay</u>		<u>116</u>
Information upon completion of well:			
(1) Diameter <u>12</u> inches.			
(2) Total Depth <u>115</u> feet.			
(3) Water Level <u>20' - 4"</u> feet below top of ground.			
(4) Cased to <u>55'</u> , Size <u>12"</u>			
(5) Screen: Size <u>12"</u> , Length <u>60'</u>			
(6) Were any formations sealed against pollution?			
_____ yes, <u>no</u> no.			
If YES depth of formation _____			
Why _____			
Drillers Remarks: _____			
<u>1200 GPM</u>			
<u>engine drive</u>			

CODED

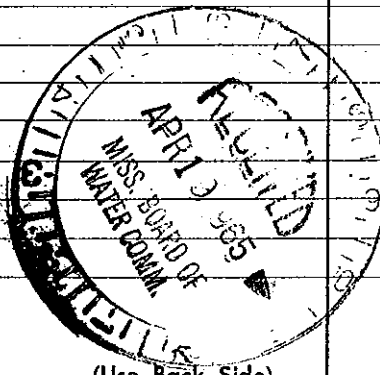

(Use Back Side)

Well No.

Mail this copy to Board of Water Commissioners 429 Miss. St. Jackson, Miss