

BOLIVAR MISSISSIPPI BOARD OF WATER COMMISSIONERS

B-31

WATER WELL DRILLERS LOG

7-16-65

CODED

Date: 7-16, 1965, Driller: John Burt Tanner Bolivar County, Mississippi
(Name)

(1) Owner of Land: M. Murely Turner
(Name)
DUNCAN MISS
(Address)

(2) Location: 1/4, 1/4, Sec. 15 T25R5
2 1/2 miles EAST of DUNCAN
(distance) (direction) (Nearest Town)

(3) Topography: Flat
(Hilly) (Flat) (Level)

(4) Purpose of Well: Irrigation
(Domestic Irrigation
Municipal, Industrial, Other)

Description & Color of Materials Sand, Clay, Red Clay, Shell, etc.	Thick- ness Feet	Depth Feet
Buckshot zone		27 1/2
Blue mud	13	40 1/2
Blue mud	6 1/2	47
Coarse sand	6 1/2	53 1/2
Mid + coarse sand	6 1/2	60
Coarse sand	6 1/2	66 1/2
Coarse sand + gravel	6 1/2	73
Coarse sand	13	86
Sand + small gravel	7 1/2	93 1/2
Bentonite just above blue mud clay		

Information upon completion of well:

(1) Diameter 6 inches.


(2) Total Depth 111 feet.

(3) Water Level 22 feet below top of ground.

(4) Cased to 63', Size 6"

(5) Screen: Size 6", Length 48'

(6) Were any formations sealed against pollution?
_____ yes, _____ no.

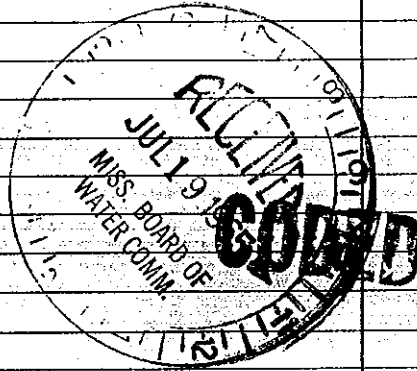

If YES depth of formation _____

Why _____

Drillers Remarks: [Signature]

(Use Back Side)

Well No.

Mail this copy to Board of Water Commissioners 429 Miss. St. Jackson, Miss.