

BOLIVAR MISSISSIPPI BOARD OF WATER COMMISSIONERS

B - 32
5-24-65


WATER WELL DRILLERS LOG

Date: 5/24, 1965, Driller: Bailey Drilling Co. (Name)

CODED

(1) Owner of Land: <u>Stapp Plantation</u> (Name) <u>Duncan, Miss.</u> (Address)	Description & Color of Materials Sand, Clay, Red Clay, Shell, etc.	Thick- ness Feet	Depth Feet
	<u>Clay</u>		<u>25</u>
	<u>Sand</u>		<u>78</u>
	<u>Gravel</u>		<u>130</u>
(2) Location: <u>1/4</u> , <u>10, 11</u> <u>19</u> <u>T2S R 5</u> <u>2</u> miles <u>E</u> of <u>Duncan</u> (distance) (direction) (Nearest Town)	<u>Mud</u>		<u>225</u>
	<u>Sand</u>		<u>780</u>
	<u>Mud + Rocks</u>		<u>1118</u>
(3) Topography: <u>Flat</u> (Hilly) (Flat) (Level)	<u>Mud + Sand</u>		<u>1130</u>
	<u>Mud</u>		<u>1191</u>
(4) Purpose of Well: <u>Domestic</u> (Domestic Irrigation Municipal, Industrial, Other)	<u>Fine sand + Mud</u>		<u>1370</u>
	<u>Mud</u>		<u>1378</u>
	<u>Fine sand + Mud</u>		<u>1360</u>
	<u>Sand</u>		<u>1435</u>
Information upon completion of well:			
(1) Diameter: <u>4 X 3 X 2 1/2</u> inches.			
(2) Total Depth: <u>1435</u> feet.			
(3) Water Level: <u>1</u> <u>above</u> feet below top of ground.			
(4) Cased <u>all way</u> , Size <u>4 X 3 X 2 1/2</u>			
(5) Screen: Size <u>2 1/2</u> , Length <u>30 ft</u>			
(6) Were any formations sealed against pollution? <u>yes</u> , <input checked="" type="checkbox"/> <u>no</u> .			
If YES depth of formation _____			
Why _____			
Drillers Remarks: _____			

CODED

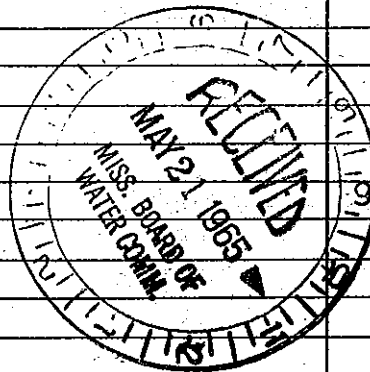

Well No.

(Use Back Side)

Mail this copy to Board of Water Commissioners 429 Miss. St. Jackson, Miss.