

BOLIVAR MISSISSIPPI BOARD OF WATER COMMISSIONERS

B 3/6

2-22-62 WATER WELL DRILLERS LOG CODED 1203

Date: Feb. 22, 1962, Driller: Layne-Central Company County Bolivar

(Name)

(1) Owner of Land: School
Brooks Elementary
(Name)
Duncan, Mississippi
(Address)

(2) Location: 1/4, 1/4, Sec. 18 T²⁵N R⁵W
_____ miles south of Duncan
(distance) (direction) (Nearest Town)

(3) Topography: flat
(Hilly) (Flat) (Level)

(4) Purpose of Well: domestic
(Domestic Irrigation
Municipal, Industrial, Other)

Description & Color of Materials Sand, Clay, Red Clay, Shell, etc.	Thick- ness Feet	Depth Feet
Clay	21	21
Fine sand	51	72
Coarse sand & pea gravel	70	121
Clay	24	145
Sandy clay	18	163
Sand & clay strks.	15	178
Sand & small clay strks.	118	296
Clay	16	312
Sand & clay strks.	56	368
Sandy clay	7	375
Sand	61	436
Clay	17	453
Clay & sandy clay	43	506
Sand & clay strks.	12	518
Sandy shale	27	545
Sandy shale & clay strks.	45	590
Clay	64	654
Fine sand & clay strks.	57	711
Clay & fine sand	17	728
Sand	28	756
Cement sand	1	757
Sand & clay	12	769
Clay & sandy shale strks.	82	851
Clay & shale	52	903
Rocks & shale	20	923
Shale & sandy shale strks.	20	943
Rock	2	945
Shale	2	947
Rock	2	949
Clay and shale	48	997
Rock	1	998
Clay & shale	17	1015

Information upon completion of well:

(1) Diameter 6x3 inches.

(2) Total Depth 1460 feet.

(3) Water level flowing feet below top of ground 1236' -8" 3"



(4) Cased to 201' Size 6"
22' -8" Lap

(5) Screen: Size 3" Length 40' -4"
3' -1" B.P.V.

(6) Were any formations sealed against pollution?
yes yes, no no.

If YES depth of formation 6" cemented in place; lix6 mechanical seal and packer above the screen.

Drillers Remarks:

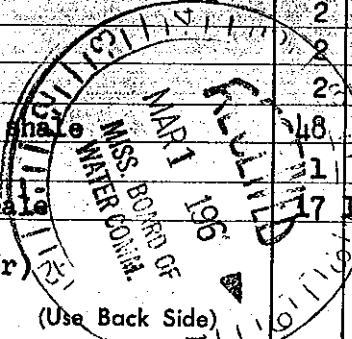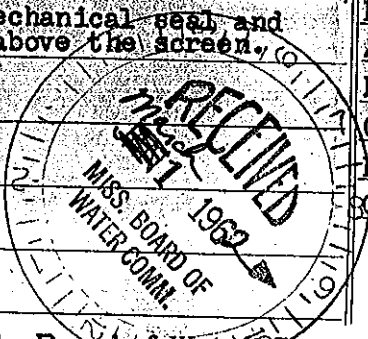

(over)

(Use Back Side)

Well No.

Mail this copy to Board of Water Commissioners 429 Miss. St. Jackson, Miss