

BOLIVAR MISSISSIPPI BOARD OF WATER COMMISSIONERS ^{Coded} B-300

B 50

7-8-60

WATER WELL DRILLERS LOG

^{Bolivar} CODED

Date: 7/8/60, 1960, Driller: Gene County, Gene County ^{Gene}

(1) Owner of Land: E. R. McMurtry
(Name)
Duncan, Miss
(Address)

Description & Color of Materials Sand, Clay, Red Clay, Shell, etc.	Thick- ness Feet	Depth Feet
<u>clay</u>	<u>35</u>	<u>35</u>
<u>clay sand</u>	<u>15</u>	<u>50</u>
<u>of sand</u>	<u>5</u>	<u>55</u>

(2) Location: 1/4, 1/4, Sec. 27 T25R5
3 miles east of Duncan
(distance) (direction) (Nearest Town)

<u>caprock sand pea</u>		
<u>shovel</u>	<u>39</u>	<u>94</u>


(3) Topography: level
(Hilly) (Flat) (Level)

(4) Purpose of Well: Irrigation
(Domestic Irrigation, Municipal, Industrial, Other)

CODED

Information upon completion of well:

- (1) Diameter 16 inches.
- (2) Total Depth 94 1/2 feet.
- (3) Water Level 30 feet below top of ground.
- (4) Cased to 67 1/2, Size 16
- (5) Screen: Size 12, Length 27
- (6) Were any formations sealed against pollution?
no

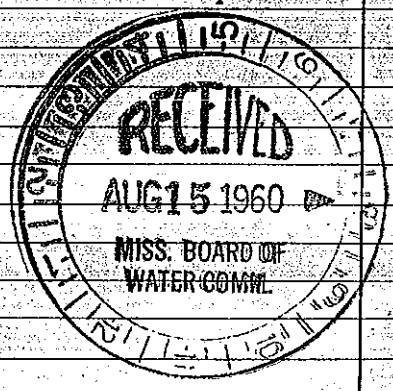

If YES depth of formation
Why
Drillers Remarks: Pumping
2300 g.p.m.

Well No.

(Use Back Side)

Mail this copy to Board of Water Commissioners 429 Miss. St. Jackson, Miss.