

BOLIVAR MISSISSIPPI BOARD OF WATER COMMISSIONERS

B 55
11-11-63 CODED WATER WELL DRILLERS LOG

CODED 11/19/63
 1701

Date: Nov. 11, 1963, Driller: Layne-Central Company County Bolivar

(Name)

(1) Owner of Land: G. A. Hood
 (Name)
Duncan, Mississippi
 (Address)

(2) Location: 1/4, 1/4, Sec. 4 T 26N R 5W
 (distance) (direction) (Nearest Town) of Duncan

(3) Topography: flat
 (Hilly) (Flat) (Level)

(4) Purpose of Well: domestic
 (Domestic Irrigation
 Municipal, Industrial, Other)

Description & Color of Materials Sand, Clay, Red Clay, Shell, etc.	Thick- ness Feet	Depth Feet
Clay	3	3
Sand and clay	15	18
Sand	12	30
Coarse sand and pea gravel		
	104	134
Clay	133	267
Sand and sand streaks	44	311
Clay	54	365
Sand and shale streaks	28	393
Sand	45	438

Information upon completion of well:

(1) Diameter 3 inches.

(2) Total Depth 438 feet.

(3) Water Level 17 feet below top of ground.

(4) Cased to 405' - 4", Size 3".


(5) Screen: Size 3", Length 30' - 1"
 B.P.V. 2' - 7"

(6) Were any formations sealed against pollution?
yes yes, no no.

If YES depth of formation Cloth packer
20' above screen.
 Why

Drillers Remarks:

CODED

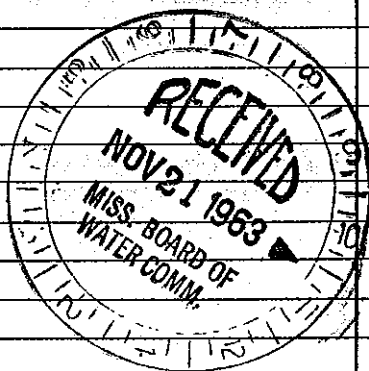

(Use Back Side)

Well No.

Mail this copy to Board of Water Commissioners 429 Miss. St. Jackson, Miss