

BOLIVAR  
B. 56

MISSISSIPPI BOARD OF WATER COMMISSIONERS

7-46/18/65  
C199872

WATER WELL DRILLERS LOGGED  
CODED

Date: June 3, 1965, Driller: Layne-Central Company County Bolivar

(Name)

(1) Owner of Land: Alfred Butler  
(Name)  
Alligator, Mississippi  
(Address)  
T26N  
(2) Location: 1/4, 1/4, Sec. 32 T R5W  
2 miles west of Alligator  
(distance) (direction) (Nearest Town)  
(3) Topography: flat  
(Hilly) (Flat) (Level)  
(4) Purpose of Well: irrigation  
(Domestic Irrigation  
Municipal, Industrial, Other)


Description & Color of Materials Sand, Clay, Red Clay, Shell, etc.	Thick- ness Feet	Depth Feet
Clay	2	2
Fine sand	33	35
Coarse sand, pea gravel	35	70
Gravel & sand	32	102
Boulders & cement sand stone	2	104

Information upon completion of well:

(1) Diameter 12 inches.  
(2) Total Depth 105' feet.  
(3) Water Level 16'-7" feet below top of ground.  
(4) Cased to 65', Size 12"  
(5) Screen: Size 12", Length 40'  
(6) Were any formations sealed against pollution?  
no yes, no no.

If YES depth of formation \_\_\_\_\_  
Why \_\_\_\_\_  
Drillers Remarks: \_\_\_\_\_

CODED

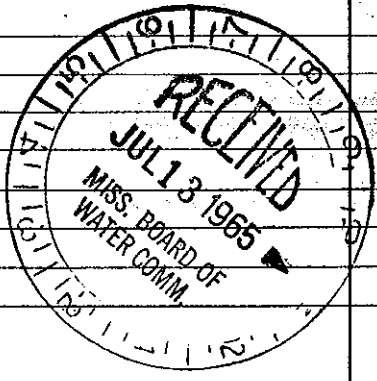

(Use Back Side)

Well No.

Mail this copy to Board of Water Commissioners 429 Miss. St. Jackson, Miss.