

BOLIVAR

B 57

MISSISSIPPI BOARD OF WATER COMMISSIONERS

6-7-65

CODED

WATER WELL DRILLERS LOG

CODED

#3 6/18/65
C1998

Date: June 7, 1965, Driller: Layne-Central Company County Bolivar

(Name)

		Description & Color of Materials Sand, Clay, Red Clay, Shell, etc.	Thick- ness Feet	Depth Feet
(1) Owner of land: <u>Alfred Butler</u> (Name)		<u>Clay</u>	12	12
<u>Alligator, Mississippi</u> (Address)		<u>Fine sand</u>	23	35
(2) Location: <u>1/4</u> , <u>1/4</u> , Sec. <u>30</u> T <u>R5W</u> <u>2</u> miles <u>northwest</u> of <u>Alligator</u> (distance) (direction) (Nearest Town)		<u>Fea gravel, coarse sand</u>	45	80
(3) Topography: <u>flat</u> (Hilly) (Flat) (Level)		<u>Gravel & sand</u>	25	105
(4) Purpose of Well: <u>irrigation</u> (Domestic Irrigation Municipal, Industrial, Other)				

Information upon completion of well:


- (1) Diameter 12 inches.
- (2) Total Depth 104 feet.
- (3) Water Level 17' - 1" feet below top of ground.
- (4) Cased to 64', Size 12"
- (5) Screen: Size 12", Length 40'
- (6) Were any formations sealed against pollution?
_____ yes, no no.

If YES depth of formation _____

Why _____

Drillers Remarks: _____

CODED

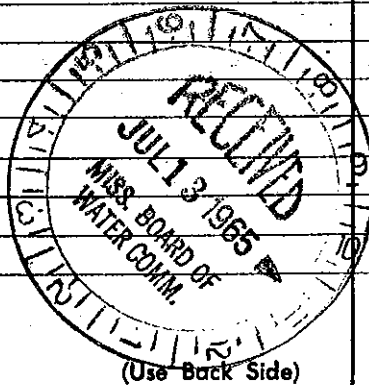

Well No.

Mail this copy to Board of Water Commissioners 429 Miss. St. Jackson, Miss.