

*Bolivar*  
*B 58*  
*5-66*

MISSISSIPPI BOARD OF WATER COMMISSIONERS

CODED

CODED

WATER WELL DRILLERS LOG

*Bolivar*

Date: May 12, 1966, Driller: Butane Gas Co. County ~~LeFlore~~


(Name)

(1) Owner of Land: <u>Wendel Chudy</u> (Name)	Description & Color of Materials Sand, Clay, Red Clay, Shell, etc.	Thick- ness Feet	Depth Feet
<u>Cleveland, Miss.</u> (Address)	Clay	13	13
	"	10	23
(2) Location: <u>SE 1/4, NW 1/4, Sec. 22 T<sup>25</sup> N<sup>5</sup> R<sup>12</sup> W</u> <u>3 1/2 SE</u> miles <u>East</u> of <u>Duncan</u> (distance) (direction) (Nearest Town)	Blue Clay	10	33
	Blue Clay & Sand	10	43
	Coarse sand & gravel	10	53
(3) Topography: <u>Flat</u> (Hilly) (Flat) (Level)	" " "	10	63
(4) Purpose of Well: <u>Irrigation</u> (Domestic Irrigation Municipal, Industrial, Other)	" " "	10	73
	" " "	10	83
	" " "	10	93
	" " "	10	103
	" " "	10	113

Information upon completion of well:

- (1) Diameter 16 inches.
- (2) Total Depth 113 feet.
- (3) Water Level 20 feet below top of ground.
- (4) Cased to 73, Size 16
- (5) Screen: Size 16, Length 40
- (6) Were any formations sealed against pollution?  
 yes,  no.

CODED

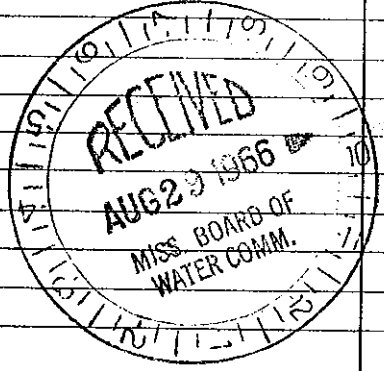

If YES depth of formation \_\_\_\_\_  
 Why \_\_\_\_\_  
 Drillers Remarks: \_\_\_\_\_  
 \_\_\_\_\_  
 \_\_\_\_\_

Well No.

(Use Back Side)

tain this copy for your office files.