

CODED

CODED

BOLIVAR  
B 59  
6-67

MISSISSIPPI  
BOARD OF WATER COMMISSIONERS  
416 North State Street  
Jackson, Mississippi 39201

WATER WELL DRILLERS LOG

23 1967 date well completed  
Five County Drillers Assn firm name  
BOLIVAR county well located

LANDOWNER McMurchel E.L.  
DUNCAN  
MISS  
(mailing address)

description of formations encountered	from	to
Buckshot Top Soil		14
Clay to fine sand	14	20 1/2
fine sand	20 1/2	66
MEP SAND	66	79
Coarse sand pea rock & gravel	79	116
Clay at 115'		116


WELL LOCATION:  
NE sec. 20 T 25 N R 5 W  
2 miles SE of DUNCAN  
(distance) (direction) (nearest town)

WELL PURPOSE: IRRIGATION  
(home, irrigation, municipal, industrial)

WELL COMPLETION DATA:

- (1) diameter (inches) 6
- (2) total depth (feet) 116
- (3) static water level (feet) 21 below above top of ground.
- (4) casing PIPE (material), 67 6 (depth),  
6 (size) if telescope see back.
- (5) screen 48' (length), 67 6 (depth to top),  
6" (size), Open 101 (material)
- (6) pump 30 (HP), 1000 (yield gpm)  
Tractor (type power)
- (7) electric log NO (yes or no)  
(organization running log)
- (8) how well bottom plugged Welded

CODED

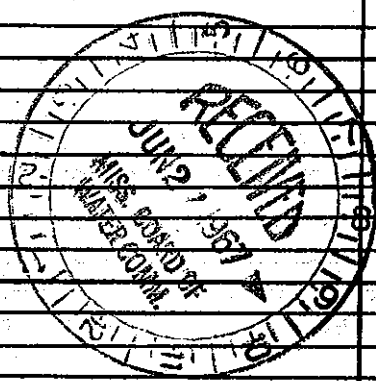

*[Signature]*

DRILLERS REMARKS: