

C17704

BOLIVAR
B 63
4-3-75


MISSISSIPPI
BOARD OF WATER COMMISSIONERS
416 North State Street
Jackson, Mississippi 39201

CODED

WATER WELL DRILLERS LOG

April 3, 1975 Singer-Layne Central Div. Bolivar
date well completed firm name county well located

LANDOWNER: <u>Wendel Chudy</u>	description of formations encountered	from	to
512 Robinson Drive Cleveland, MS (mailing address)			
WELL LOCATION: sec. <u>35</u> T <u>25</u> N R <u>5</u> W <u>5</u> miles <u>east</u> of <u>Shelby</u> (distance) (direction) (nearest town)	Clay	0	12
	Fine Sand	12	48
	Coarse Sand	48	85
	Gravel	85	104
WELL PURPOSE: <u>irrigation</u> (home, irrigation, municipal, industrial)			
WELL COMPLETION DATA: (1) diameter (inches) <u>16"</u> (2) total depth (feet) <u>104'</u> (3) static water level (feet) <u>15</u> below top of ground. (4) casing <u>steel 54'</u> (material) (depth) <u>16"</u> if telescope see back. (size) (5) screen <u>50'</u> <u>54'</u> (length) (depth to top) <u>16"</u> <u>steel</u> (size) (material) (6) pump <u>50</u> <u>2500</u> (HP) (yield gpm) <u>engine</u> (type power) (7) electric log <u>no</u> (yes or no) (organization running log) (8) how well bottom plugged <u>with plate</u>			
DRILLERS REMARKS:			

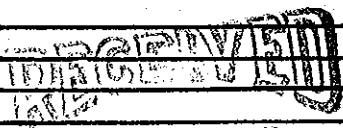

MAY 19 1975

MISS. BD. OF WATER COMMISSIONERS