

BOLIVAR MISSISSIPPI BOARD OF WATER COMMISSIONERS

B ⁶⁴ CODED
11-6-63

CODED ^{11/17/63} W.C. 1700

Date: Nov. 6, 1963, Driller: Layne-Central Company County Bolivar

(Name)

		Description & Color of Materials Sand, Clay, Red Clay, Shell, etc.	Thick- ness Feet	Depth Feet
(1) Owner of Land: <u>W. L. Hood</u> (Name)		Top soil	3	3
<u>Duncan, Mississippi</u> (Address)		Sand & clay	11	14
(2) Location: <u>1/4</u> , <u>1/4</u> , Sec. <u>4</u> ⁵ <u>T28N</u> ⁵ <u>R6W</u>		Brown sand	10	24
<u> </u> miles of <u>Duncan</u> (distance) (direction) (Nearest Town)		Coarse sand	35	59
(3) Topography: <u>flat</u> (Hilly) (Flat) (Level)		Coarse sand & pea gravel	83	142
(4) Purpose of Well: <u>domestic</u> (Domestic Irrigation Municipal, Industrial, Other)		Clay	58	200
		Sand & clay	15 1/2	35 1/2
		Clay		
		Sand		

Information upon completion of well:

- (1) Diameter 3x4 inches.
- (2) Total Depth 417 feet.
- (3) Water Level 23 feet below top of ground.
- (4) Cased to 100' 3" H.P.V. 3'-5" Size 4"
- (5) Screen: Size 3" x 11" Length 20' - 11"
- (6) Were any formations sealed against pollution?
 yes, no.


If YES depth of formation Cloth packer
40' above screen.

Why _____

Drillers Remarks: _____

CODE

392

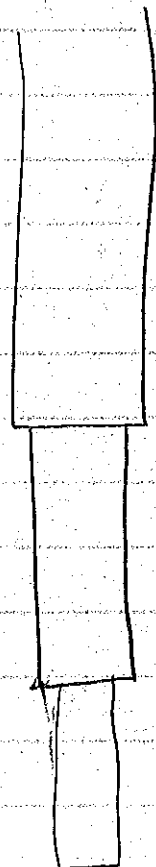

291' OF 5"

100' OF 4"

21' OF 3" screen