


BOLIVAR
CL-1525
B-86
5-5-80

MISSISSIPPI
BOARD OF WATER COMMISSIONERS
416 North State Street
Jackson, Mississippi 39201

WATER WELL DRILLERS LOG

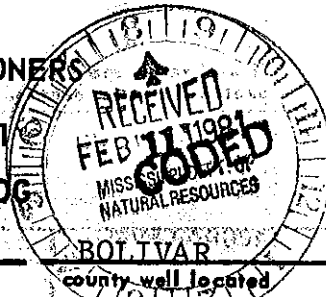

5/5/1980 date well completed
LAYNE-CENTRAL CO. firm name
BOLIVAR county well located

LANDOWNER	description of formations encountered	from	to
MC MURPHY FARMS	clay	0	14
DUNCAN, MS	"	14	22
(mailing address)	"	22	32
WELL LOCATION:	fine sand	32	42
sec 18 T 25 N R 5 E	"	42	52
4 miles SW of Duncan	coarse sand	61	62
(distance) (direction) (nearest town)	"	62	72
WELL PURPOSE: Irrigation	coarse sand & gravel	72	82
(home, Irrigation, municipal, industrial)	"	82	92
WELL COMPLETION DATA:	"	92	102
(1) diameter (inches) 24"			
(2) total depth (feet) 102'			
(3) static water level (feet) 33' below top of ground			
(4) casing steel 72' (material) (depth)			
10" (size) if telescope see back.			
(5) screen 30' 72' (length) (depth to top)			
10" st. steel (size) (material)			
(6) pump 20 1000 (HP) (yield gpm)			
electric (type power)			
(7) electric log no (yes or no)			
(organization running log)			
(8) how well bottom plugged st. plate			
DRILLERS REMARKS:			