


BOLIVAR
B 87
12/17/80

MISSISSIPPI
BOARD OF WATER COMMISSIONERS
416 North State Street
Jackson, Mississippi 39201

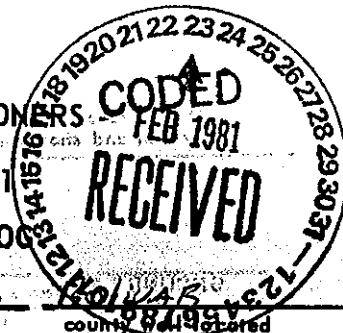

WATER WELL DRILLERS LOG

date well completed 12-17-80 1980 firm name Fair Co. Farms Clean county BOLIVAR well no. 121195

LANDOWNER: <u>Bolivar Co</u> <u>BAPTIST</u> <u>Duncan Miss</u> (mailing address)	description of formations encountered	from	to
		<u>Clay</u>	<u>1</u>
	<u>Fine sand</u>	<u>13</u>	<u>26</u>
	<u>Coarse sand</u>	<u>26</u>	<u>92</u>

WELL LOCATION:
sec 20 T 28 N R 5 E
S W
1 miles South of Duncan
(distance) (direction) (nearest town)

WELL PURPOSE:
(home, irrigation, municipal, industrial)

- WELL COMPLETION DATA:
- diameter (inches) 12
 - total depth (feet) 92'
 - static water level (feet) 22 below above top of ground.
 - casing steel, 52'
(material) (depth)
12" If telescope see back.
(size)
 - screen 40', 57'
(length) (depth to top)
12" Brown
(size) (material)
 - pump 40 960
(HP) (yield gpm)
 diesel
(type power)
 - electric log no
(yes or no)
- (organization running log)
- (8) how well bottom plugged welded

DRILLERS REMARKS:

