

BOLIVAR
B 89
1-29-81

MISSISSIPPI DEPARTMENT OF NATURAL RESOURCES

Bureau of Land and Water Resources

Southport Mall

P.O. Box 10631

Jackson, Mississippi 39209

WATER WELL DRILLERS LOG

00003

Bolivar

1/29 1981

Dyer

Catahoula

date well completed

firm name

county well located

LANDOWNER:

ELDRID SCHMIDT

Aligator ms
 (mailing address)

description of formations encountered

from to

sand	23	33
sand	33	43
sand	43	53
sand gravel	53	68
sand gravel	63	73
sand gravel	73	83
gravel	83	93
sand gravel	93	103
gravel	103	113

WELL LOCATION:


sec. 3 25 N R 5 E
 S W
1 miles S of Aligator
 (distance) (direction) (nearest town)

WELL PURPOSE:

Location
 (home, irrigation, municipal, industrial)

WELL COMPLETION DATA:

- (1) diameter (inches) 16"
- (2) total depth (feet) 113'
- (3) static water level (feet) 21' below top of ground.
- (4) casing Steel 113'
 (material) (depth)
- 16" if telescope see back.
 (size)
- (5) screen 40' 23'
 (length) (depth to top)
- 16" Steel
 (size) (material)
- (6) pump 60 3000
 (HP) (yield gpm)
- Diesel
 (type power)
- (7) electric log (yes or no) _____

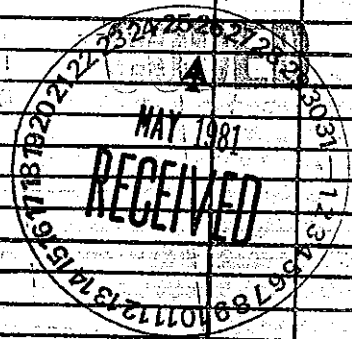

(organization running log)

(8) how well bottom plugged date

DRILLERS REMARKS: