

MISSISSIPPI DEPARTMENT OF NATURAL RESOURCES

Bureau of Land and Water Resources

Southport Mall

P.O. Box 10631

Jackson, Mississippi 39209

WATER WELL DRILLERS LOG

CODED

BOLLIVAR
B91
5-10-81

5-10-81 19 *Oysterwell & Eng. Serv. Louisiana*
date well completed film name county well located

LANDOWNER: *Doug Smith*

(mailing address)


WELL LOCATION:
sec *34* T. *26* N. R. *5* E. S. *1*
1/2 miles *NE* of *Alligator*
(distance) (direction) (nearest town)

description of formations encountered	from	to
<i>sun</i>	<i>13</i>	<i>23</i>
<i>sun</i>	<i>23</i>	<i>33</i>
<i>sun</i>	<i>33</i>	<i>43</i>
<i>clay</i>	<i>43</i>	<i>53</i>
<i>clay</i>	<i>53</i>	<i>63</i>
<i>sun & gravel</i>	<i>63</i>	<i>73</i>
<i>sun & gravel</i>	<i>73</i>	<i>83</i>
<i>sun & gravel</i>	<i>83</i>	<i>93</i>
<i>gravel</i>	<i>93</i>	<i>103</i>
<i>sun & gravel</i>	<i>103</i>	<i>113</i>

WELL PURPOSE:
(home, irrigation, municipal, industrial)

- WELL COMPLETION DATA:
- (1) diameter (inches) *16*
 - (2) total depth (feet) *113'*
 - (3) static water level (feet) *20'* below top of ground.
 - (4) casing *Steel 113'*
(material) (depth)
16
(size) If telescope see back.
 - (5) screen *40'* *73'*
(length) (depth to top)
16" *stal*
(size) (material)
 - (6) pump *60* *2000*
(HP) (yield gpm)
electric
(type power)
 - (7) electric log (yes or no)
 - (organization running log)
 - (8) how well bottom plugged *plate*

CODED

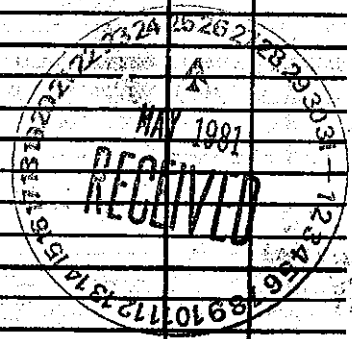

DRILLERS REMARKS: