

Bolivar  
B 98  
1-2-81

MISSISSIPPI  
 BOARD OF WATER COMMISSIONERS  
 416 North State Street  
 Jackson, Mississippi 39201

**CODED**

WATER WELL DRILLERS LOG


1-2 date well completed    81 Boys pump & Well Inc. firm name    Bolivar county well located

| LANDOWNER: <u>Rusty Burroughs</u>  | description of formations encountered | from      | to         |
|--|---------------------------------------|-----------|------------|
| <u>RT. 1 Box 217A</u><br><u>Shelby MS, 38774</u><br>(mailing address)        |                                       |           |            |
| <u>sec. 32 T. 25 N. R. 5 E</u>   | <u>Clay</u>                           | <u>0</u>  | <u>30</u>  |
| <u>4418.8 miles N of Shelby</u><br>(distance) (direction) (nearest town)     | <u>Fine Sand</u>                      | <u>30</u> | <u>60</u>  |
| <u>WELL LOCATION:</u>  | <u>Sea Shaul</u>                      | <u>60</u> | <u>70</u>  |
| <u>WELL PURPOSE: Irrigation</u><br>(home, irrigation, municipal, industrial) | <u>Large Shaul</u>                    | <u>70</u> | <u>90</u>  |
| <u>WELL COMPLETION DATA:</u>   | <u>Sand Shaul</u>                     | <u>90</u> | <u>113</u> |

**CODED**

- (1) diameter (inches) 16"
- (2) total depth (feet) 113
- (3) static water level (feet) 28 below top of ground.
- (4) casing Steel, 73'  
(material) (depth)
- (size) if telescope see back.
- (5) screen 40', 73'  
(length) (depth to top)
- 16"  
(size) (material)
- (6) pump 60, 3000  
(HP) (yield gpm)
- Diesel  
(type power)
- (7) electric log \_\_\_\_\_  
(yes or no)
- (organization running log)
- (8) how well bottom plugged Plat 14

Markham  
of House  
is of

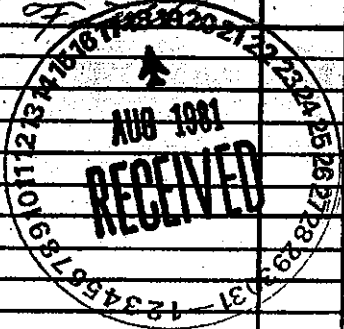

DRILLERS REMARKS: