Never r	received Part 2 3/13
State	e Well Report
County: Bolivar	Part 1 For Office Use Only:
Mississippi Depar	tment of Environmental Quality Aquifer:
	and and Water Resources Well #: B -163
	.U. B0X 10051
	601)961-5210
	1)354-6938 (fax) E-log #:
State Law requires that this report be prepared by	the driller in detail and filed with the Department within
30 days of completion of drilling of the well. Well Owner Information	Well Location
Owner Name_Ed Labry	Latitude: 34 . 04,53 " Longitude: 090 . 42 . 00 "
Mailing Address: 5763 Symmertree Dr	
	USGS quad, (Hand-held GPS.) Survey-grade GPS
Memphis TN 38/34 City State Zip Code	NW 14 SE 14 Sec 34 Twn 26N Rng 5W
Telephone No. (1612, 902-3717 - Manage	
Marshall Fulliove	Veli Data
Purpose of Well (circle one) Home Industrial Public Sup	
Date well drilling started: <u>4-28-07</u>	Date well drilling completed:
If flowing, method of flow regulation: Valve Ot	
Static Water Level: 28 feet above or below (circle	one) land surface Date measured: <u>4-28-07</u>
	tape air line other: <u>Rope & weight</u>
Hole depth: Well depth:	Well grouted to a depth offeet
Type of grout (circle one): Cement Bentonite	Mix
Casing length: <u>70</u> feet Casing diameter: <u></u>	
Screen length: <u>40</u> feet Screen diameter: <u>4</u>	inches Type of screen: <u>PVC S 107796</u>
Screen slot size:	romfeet tofeet
Type of completion (circle all applicable): Gravel packed U	Inderreamed Telescoped Open hole Natural Development
Other (describe):	
Top of lap pipe or reduction in casing: feet.	If telescoped or more than one screen, describe on back of page
Logs run (circle all applicable): No log run Electric Gamma	Ray Density Sonic Neutron Other:
Name of organization running log(s):	
I certify that the well was drilled, constructed, and complete Department of Environmental Quality and/or the Mississipp	d in accordance with all applicable requirements of the Mississippi i Department of Health regulations and state laws.
Willie L. Bryant 0-639	Will's L. Bugant
Print Name of Water Well Contractor and License No.	Signature of Water Well Contractor
Drilled For: Peacock Puma 1 k	enair Inc.
Drilled For: Peacock Pump + R. P. O. Box 4246	RECEIVE
Cleve land, MS 387	32
	MAY 2 9 200

?;

BY: OLWR


If well telescopes please sketch below and show depths.

B-163

Ground Level

Description of Formations Encountered	From	То
 Clay & Brown Sand	0	20
Brown Sand	20	40
Coarse Sand	40	60
grave/	60	80
gravel	80	100
ava vel	100	110
<u>9</u> 14/07		
		<u> </u>
······································		
		1
		+
		ļ
		1
		1
		+
		1

If more than one screen, show location of each on sketch

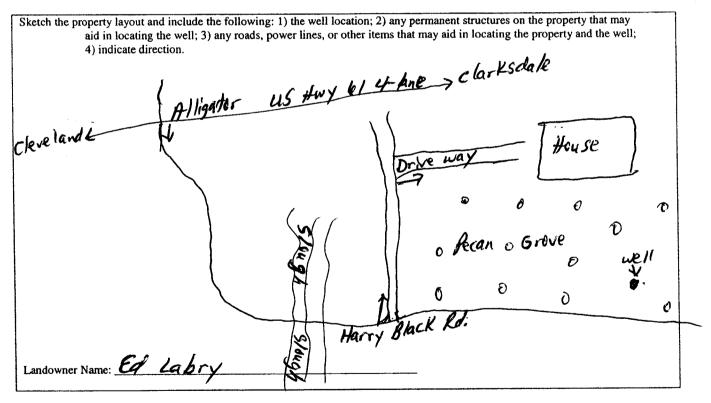

Willie K. Buyan Signature of Water Well Contractor

RECEIVED MAY 2 9 2007 BY: OLWP