

Replacement for GW-43673

STATE WELL REPORT

Part 1

Driller's Log

Mississippi Department of Environmental Quality
Office of Land and Water Resources
P.O. Box 2309
Jackson, MS 39225-2309
(601)961-5210
(601)360-0535 (fax)

For Office Use Only:

Well #: B194
Aquifer:
E-Log #:

County: Bolivar
Permit #: GW-47663
Driller: Tommy Peacock
Date drilling completed: 10-11-13

State Law requires that this report be prepared by the license holder responsible for the work and filed with the Department at the above address within 30 days of completion of drilling of the well or borehole.

Well Owner Information (Landowner if borehole is not for a water well)
Owner Name: John Fullilove
Mailing Address: P.O. box 143
Duncan MS 38746
City State Zip Code
Telephone No. (662) 902-3852
Well or Borehole Location
Latitude: 34°01'41" Longitude: 90°42'55"
Method of Lat/Long (check one): Conventional Survey
USGS quad, Hand-held GPS X, Survey-grade GPS
NE 1/4 NE 1/4, Sec 21 T 25N R 05W
1 Miles SE of Duncan
(Distance) (Direction) (Nearest Town)


Well / Borehole Data
Date drilling started: 10-11-13 Date drilling completed: 10-11-13 Hole depth: 120' Hole diameter: 26"
Location of the source of any surface water used for drilling: old well
Method of dosing and volume of Chlorine used in drilling and development: chlorinated in tank
Logs run (circle all applicable): No log run Electric Gamma Ray Density Sonic Neutron Other:
Name of organization running log(s):
Purpose of borehole (circle one) Water Well Geotechnical/Geological Investigation Ground Source Heat Pump
Seismic Survey Other (describe)

If drilling is not related to water well construction, skip the remainder of this block

Purpose of Well (circle all applicable): Home Industrial Public Supply Irrigation Fish Culture
Other (describe):
If a flowing well, method of flow regulation: Valve Other (describe)
Static Water Level: 42' feet [above or below] land surface Date measured:
Method of measurement (circle one): Steel tape Electric tape Air line Other (describe):
Well depth: 120 Well grouted to a depth of: 10 feet Type of grout (circle one): Neat Cement Bentonite Mix
Casing length: 80 feet Casing diameter: 16 inches Type of casing: PVC
Screen length: 40 feet Screen diameter: 16 inches Type of screen: PVC
Screen slot size: .050 inches Setting depth: From 80 feet to 120 feet
Type of completion (circle all applicable): Gravel packed Underreamed Open hole Natural Development
Other (describe):
Top of lap pipe or reduction in casing: feet

If telescoped or more than one screen, describe on next page

RECEIVED
NOV 08 2013
BY: OLWR
Form: OI WR-SWR-1A (7/11)

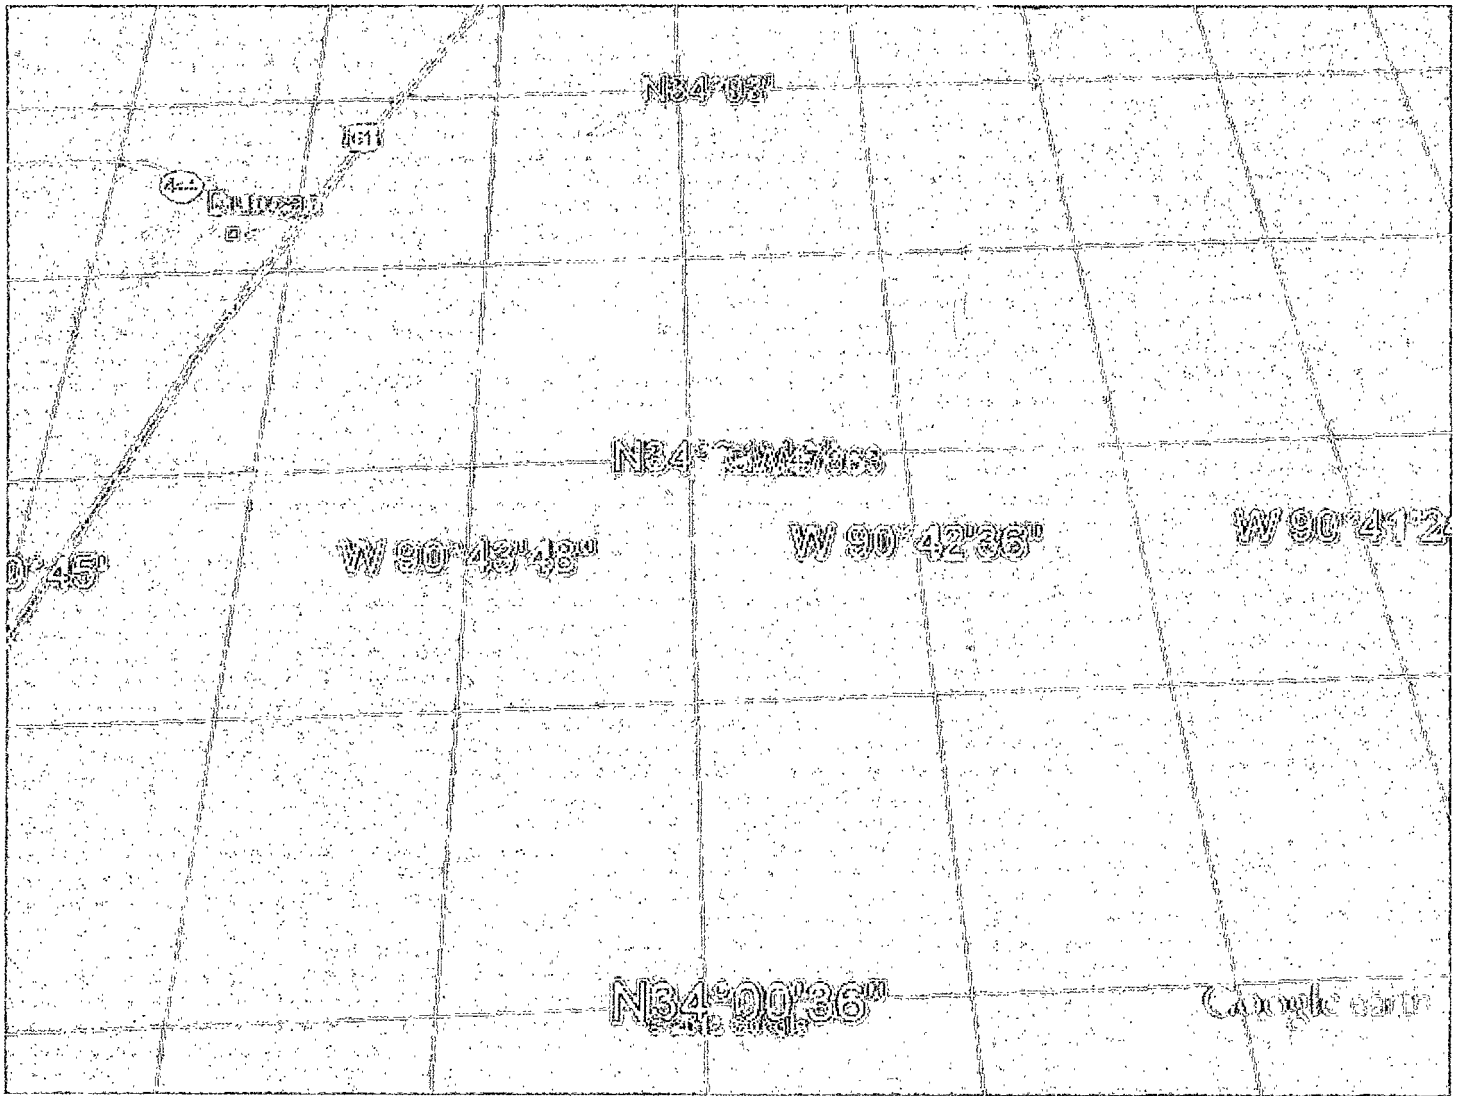

Google earth

RECEIVED
 NOV 08 2013
 BY: OLWR