	STATE WELL REPORT	F. Off . H. Orb.		
County: BOIVAY	Part 1	For Office Use Only: Well #: 3 195		
Permit #: 6W- 41846	Driller's Log Mississippi Department of Environmental Quality	, , ,		
Driller: Joel Jumper	Office of Land and Water Resources P.O. Box 2309	Aquifer:		
Date drilling completed: 1-29-14	Jackson, MS 39225-2309	E-LOg #.		
	(601)961-5210 (601)360-0535 (fax)			
State Law requires that this report be prepared by the license holder responsible for the work and filed with the Department at the above address within 30 days of completion of drilling of the well or borehole.				
Well Owner Information (Landowner if borehole is not for a		ehole Location		
Owner Name: Dale Sul	Latitude: 34-06-43 Lo	ngitude: <u>90-59-99</u>		
110	Method of Lat/Long (check one	e): Conventional Survey,		
Mailing Address: Africa	USGS quad, Hand-held C	GPS, Survey-grade GPS		
Clark color	IN 1 1/ 1 / A .	24 + 26NROSWA		
City State	Zip Code			
Telephone No. ()		(Nearest Town)		
	Well / Perchain Data			
Well / Borehole Data Date drilling started: 105 Hole diameter: 28in				
Location of the source of any surface water used for drilling:				
Method of dosing and volume of Chlorine	e used in drilling and development:			
Logs run (circle all applicable): No log run Electric Gamma Ray Density Sonic Neutron Other:				
Name of organization running log(s):				
Purpose of borehole (circle one) Water	Purpose of borehole (circle one). Water Well Geotechnical/Geological Investigation Ground Source Heat Pump			
	Survey Other (describe)			
	ted to water well construction, skip the remainde			
Purpose of Well (circle all applicable): Home Industrial Public Supply (rrigation) Fish Culture				
Other (describe):	And the second s			
If a flowing well, method of flow regulation: Valve Other (describe)				
Static Water Level: 35 feet [above or below] land surface Date measured: 1-29-14				
Method of measurement (circle one) Steel tape Electric tape Air line Other (describe):				
Well depth: 105 Well grouted to a depth of: 10 feet Type of grout (circle one): Neat Cement Sentonite Mix				
Casing length: 05 feet Casing diameter: 10 inches Type of casing: 0VC				
Screen length: 40 feet Screen diameter: 10 inches Type of screen: 10				
Screen slot size:				
Type of completion (circle all applicable) Gravel packed Underreamed Open hole Natural Development				

___feet

If telescoped or more than one screen, describe on next page


Other (describe):___

Top of lap pipe or reduction in casing: ___

FER 20 701

The sketch below only required for water wells

If well telescopes, show depths on sketch.

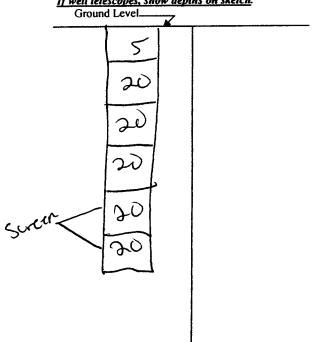

Description of formations encountered must be provided for all wells and boreholes, unless specifically exempted by regulations

Description of Formations Encountered	From (depth)	To (depth)
Clay	Ground Level	3-0
Clay	20	40
Claul	40	Leo
arad	180	60
Jarasal	80	WO
areul	100	105
Jelan		
		<u> </u>

Clarksdale If more than one screen, show location of each on sketch Sketch the property layout and include the following: 1) the well location; 2) any permanent structures on the property that may aid in locating the well; 3) any roads, power lines, or other items that may aid in locating the property and the well; 4) a north arrow. Landowner Name: Form: OLWR-SWR-1A (04/08)

I certify that the well/borehole was drilled, constructed, and completed in accordance with all applicable requirements of the Mississippi Department of Environmental Quality and the Mississippi Department of Health regulations, in applicable Print Name of Responsible Licensee and License No. Date

BY: OLWR

STATE WELL REPORT

Bolivar County: Permit #: 6W-47846 Driller: Date completed:

Copy information from block on Part 1

Part 2

Pump Installer's Completion Report Mississippi Department of Environmental Quality Office of Land and Water Resources P.O. Box 2309 Jackson, MS 39225-2309

(601)961-5210 (601) 360-0535 (fax)

For 6	Offic	e Use	e Only:	
Well #:	B	199		
Aquifer:				

	well contractor or a licensed pump installer. A copy of Part 1 Department at the above address within 30 days of well completion.			
Well Owner Information	Well Location			
Owner Name: <u>Jale Schmidt</u>	Latitude: 34-010-43 Longitude: 90-39-49			
Mailing Address: 1630 13060	Method of Lat/Long (check one): Conventional Survey,			
New Atrica Ka	USGS quad, Hand-held GPS, Survey-grade GPS			
Clarksdale Ms 38614	SE 1/4 NE 1/4, Sec 24 T 26N R OSW			
City State Zip Code	2 Miles SE of 13000			
Telephone No. ()	(Distance) (Direction) (Nearest Town)			
Pump Typ	oe (circle one)			
Submersible Turbine Air Lift Centrifugal Flowing Well	Jet Piston Rotary Other (describe):			
Date Pump Installed: 1-29-14 R	lated Pump Capacity: 3600 Gallons Per Minute			
Is This Pump (circle one): New Repaired Replacemen	t			
Power Typ	oe (circle one)			
Electric Diesel Gasoline Natural Gas Tractor PTO Wind	dmill Other (describe):			
Horse Power Rating of Motor: Setting Depti	h: 70 feet Number of Stages: 2			
Pump Test Data f	for Non Flowing Well			
Date Well Tested: Pump Test Data for Non Flowing Well Duration of Pump Test (minimum 4 hours): hours				
Static Water Level (A): 35 Feet Below Land Surface Pumping Water Level (B): 48 Feet Below Land Surface				
Drawdown [(B) - (A)]: 48 Feet Below Land Surface Test Pumping Rate: 3000 Gallons Per Minute				
Method of measurement (circle one): Steel tape Electric tape Air line Other (describe):				
Pump Test Data	a for Flowing Well			
Measured shut in head:feet.				
Well yielded 7000 GPM with a drawdown of 4	6 feet after hours of pumping			
Meter Installation				
Meter Manufacturer:	Meter Serial Number:			
Meter Model Number/Name:	Type of Meter:			
Totalizer Register Unit and Multiplier Factor (AF x .001, gal x 1000, etc):				
Installation Date: Meter installed by:				
ls This Meter (circle one): New Repaired Replacemen	nt			
Important: By submitting the above information you are cer				

I HEREBY CERTIFY that the above statements are true to the	best of my knowledge) RECEIVEL
Joel Junger 5317	Date Signature of Pyrhp Installer
Print Name of Pump Installer and License No. (if applicable)	Date Signature of Pump Installer
AND THE RESIDENCE OF THE PROPERTY OF THE PROPE	Form: OLWR-SWR-18 (4/13)
	Form: OLWR-SWR-18 (4/13) BY: OLWF