

# STATE WELL REPORT

## Part 1

### Driller's Log

Mississippi Department of Environmental Quality  
Office of Land and Water Resources  
P.O. Box 2309  
Jackson, MS 39225-2309  
(601)961-5210  
(601)360-0535 (fax)

#### For Office Use Only:

Well #: B 280  
Aquifer: \_\_\_\_\_  
E-Log #: \_\_\_\_\_

County: Bolivar  
Permit #: GW-48399  
Driller: Tommy Peacock  
Date drilling completed: 9/26/14

*State Law requires that this report be prepared by the license holder responsible for the work and filed with the Department at the above address within 30 days of completion of drilling of the well or borehole.*

Well Owner Information <small>(Landowner if borehole is not for a water well)</small>	Well or Borehole Location
Owner Name: <u>Brushy Lake Farms</u>	Latitude: <u>34°3'58"</u> Longitude: <u>90°43'25"</u>
Mailing Address: <u>7 Cypress Ridge Drive</u>	Method of Lat/Long (check one): Conventional Survey _____, USGS quad _____, Hand-held GPS <u>X</u> , Survey-grade GPS _____
<u>Clarksdale</u> MS <u>38614</u>	<u>SE</u> ¼ <sup>SW</sup> <u>SE</u> ¼, Sec <u>33</u> T <u>26</u> N R <u>05</u> W
City State Zip Code	<u>7</u> Miles <u>south</u> of <u>Alligator</u>
Telephone No. <u>(662) 902-7063</u>	(Distance) (Direction) (Nearest Town)

**Well / Borehole Data**

Date drilling started: 9/26/14 Date drilling completed: 9/26/14 Hole depth: 115' Hole diameter: 26"

Location of the source of any surface water used for drilling: ditch 3 miles East of well site

Method of dosing and volume of Chlorine used in drilling and development: chlorinated in tanker

Logs run (circle all applicable): No log run Electric Gamma Ray Density Sonic Neutron Other: \_\_\_\_\_

Name of organization running log(s): \_\_\_\_\_

Purpose of borehole (circle one): Water Well Geotechnical/Geological Investigation Ground Source Heat Pump  
Seismic Survey Other (describe) \_\_\_\_\_

*If drilling is not related to water well construction, skip the remainder of this block*

Purpose of Well (circle all applicable): Home Industrial Public Supply Irrigation Fish Culture

Other (describe): \_\_\_\_\_

If a flowing well, method of flow regulation: Valve \_\_\_\_\_ Other (describe) \_\_\_\_\_

Static Water Level: \_\_\_\_\_ feet [above or below] land surface Date measured: \_\_\_\_\_  
(circle one)

Method of measurement (circle one): Steel tape Electric tape Air line Other (describe): \_\_\_\_\_

Well depth: 115 Well grouted to a depth of: 10 feet Type of grout (circle one): Neat Cement Bentonite Mix

Casing length: 75 feet Casing diameter: 16 inches Type of casing: PVC

Screen length: 40 feet Screen diameter: 16 inches Type of screen: PVC

Screen slot size: .032 inches Setting depth: From 75 feet to 115 feet


Type of completion (circle all applicable): Gravel packed Underreamed Open hole Natural Development

Other (describe): \_\_\_\_\_

Top of lap pipe or reduction in casing: \_\_\_\_\_ feet

*If telescoped or more than one screen, describe on next page*



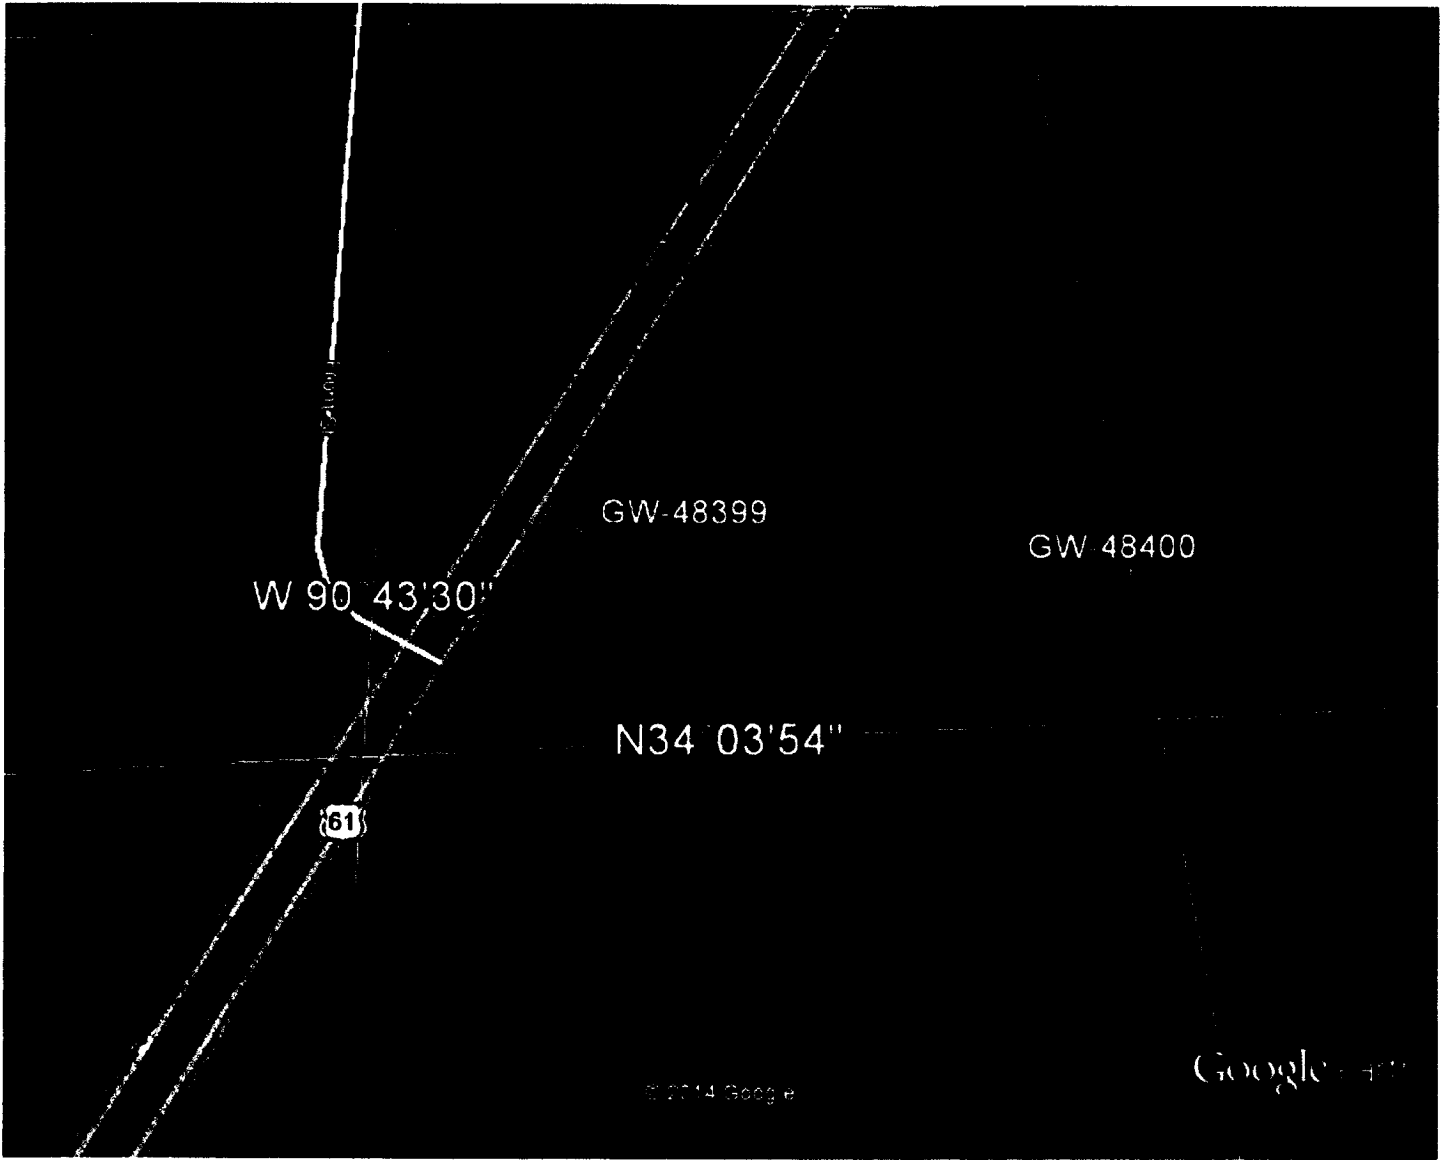

Google earth



B 200

Handwritten notes and scribbles in the bottom right corner of the page.

# STATE WELL REPORT

## Part 2

### Pump Installer's Completion Report

Mississippi Department of Environmental Quality  
Office of Land and Water Resources  
P.O. Box 2309  
Jackson, MS 39225-2309  
(601)961-5210  
(601) 360-0535 (fax)

For Office Use Only:

Well #: \_\_\_\_\_

Aquifer: \_\_\_\_\_

County: BOLEVAR  
Permit #: GW-48379  
Driller: TOMMY PAROCK  
Date completed: 9-26-14  
Copy information from block on Part 1

*This part of the report must be completed by a licensed water well contractor or a licensed pump installer. A copy of Part 1 of the report must be attached and both parts filed with the Department at the above address within 30 days of well completion.*

#### Well Owner Information

Owner Name: BASS FARMS  
Mailing Address: 7 CYPRESS RIDGE DR  
CLARKSDALE MS 38814  
City State Zip Code  
Telephone No. (662) 627-7827

#### Well Location

Latitude: 34° 04' 33" Longitude: 90° 42' 46"  
Method of Lat/Long (check one): Conventional Survey \_\_\_\_\_  
USGS quad \_\_\_\_\_, Hand-held GPS \_\_\_\_\_, Survey-grade GPS \_\_\_\_\_  
SE ¼ SE ¼, Sec 33 T 26N R 05W  
1 Miles SSE of ALLEGATOR  
(Distance) (Direction) (Nearest Town)

#### Pump Type (circle one)

Submersible  Turbine Air Lift Centrifugal Flowing Well Jet Piston Rotary Other (describe): \_\_\_\_\_

Date Pump Installed: 10-3-14 Rated Pump Capacity: 2200 Gallons Per Minute

Is This Pump (circle one): New  Repaired Replacement

#### Power Type (circle one)

Electric  Diesel Gasoline Natural Gas Tractor PTO Windmill Other (describe): \_\_\_\_\_

Horse Power Rating of Motor: 60 Setting Depth: 70 feet Number of Stages: 2

#### Pump Test Data for Non Flowing Well

Date Well Tested: \_\_\_\_\_ Duration of Pump Test (minimum 4 hours): \_\_\_\_\_ hours

Static Water Level (A): \_\_\_\_\_ Feet Below Land Surface Pumping Water Level (B): \_\_\_\_\_ Feet Below Land Surface

Drawdown [(B) - (A)]: \_\_\_\_\_ Feet Below Land Surface Test Pumping Rate: \_\_\_\_\_ Gallons Per Minute

Method of measurement (circle one): Steel tape Electric tape Air line Other (describe): \_\_\_\_\_

#### Pump Test Data for Flowing Well

Measured shut in head: \_\_\_\_\_ feet.

Well yielded \_\_\_\_\_ GPM with a drawdown of \_\_\_\_\_ feet after \_\_\_\_\_ hours of pumping

#### Meter Installation

Meter Manufacturer: McCrometer Meter Serial Number: 14-13333

Meter Model Number/Name: M0308 Type of Meter: GROUNDWATER

Totalizer Register Unit and Multiplier Factor (AF x .001, gal x 1000, etc): \_\_\_\_\_

Installation Date: 10-3-14 Meter installed by: CIRCLE S IRRIGATION

Is This Meter (circle one):  New Repaired Replacement

*Important: By submitting the above information you are certifying that this meter was installed to manufacturer standards. For agricultural wells, a list of approved meters is on the MDEQ website.*

I HEREBY CERTIFY that the above statements are true to the best of my knowledge.

DAVID P. HOLT 0-752P  
Print Name of Pump Installer and License No. (if applicable)

10-15-14  
Date

*[Signature]*  
Signature of Pump Installer

**RECEIVED**  
OCT 20 2014

