

MISSISSIPPI DEPARTMENT OF ENVIRONMENTAL QUALITY

Office of Land and Water Resources

P. O. Box 10631
Jackson, MS 39289-0631
WATER WELL DRILLERS LOG

COUNTY WELL LOCATED Bolivar	
WELL NUMBER 20	CODED
DATE WELL COMPLETED 12-21-00	

PERMIT NUMBER
NAME OF DRILLING FIRM Bryant Well & Pump Ser.
Clarksdale MS

NAME & MAILING ADDRESS OF LANDOWNER Jimmy Norman			
Rt. 1 Box 2			
Alligator, MS 38720			
WELL LOCATION	SEC	TOWNSHIP	RANGE
	22	26	5
		(N)	(E)
DISTANCE	DIRECTION	NEAREST TOWN	
1 1/2 Miles	West	of Bobo	
OTHER LANDMARK Bobo - Alligator County Line Rd.			
WELL PURPOSE Home, Irrigation, Municipal, Industrial, Fish Pond, etc. Home			

PUMP DATA		
PUMP TYPE (Circle One): Submersible, Turbine, Jet, Flowing Well, Other (Describe) _____		
POWER TYPE (Circle One): Electric, Tractor, Diesel, Gasoline, Butane, Other (Describe) _____ H/P _____		
Pump Capacity (GPM)	No. of Stages	Setting Depth FT.
PUMP TEST Set by Hillman Well & Pump		
Well yielded _____ GPM with a drawdown of _____ ft. after _____ hours of pumping		

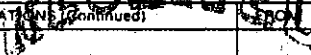
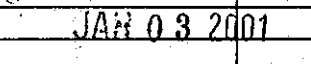

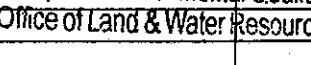
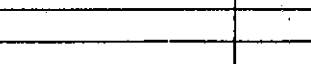
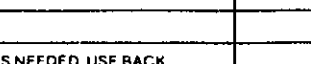

WELL DATA		
Well Depth 102'	Casing Diameter (In.) 4" PVC	Casing Length (Ft.) 82'
Type of Casing PVC 160	Hole Depth 102'	Depth to Static Water Level 21'
TYPE OF COMPLETION: (Circle One or More): <input checked="" type="checkbox"/> Gravel Packed, <input type="checkbox"/> Underreamed, <input type="checkbox"/> Telescoped, <input type="checkbox"/> Natural Development, <input type="checkbox"/> Open Hole, <input type="checkbox"/> Other (Describe) _____		
WELL GROUTED TO A DEPTH OF 25 FEET Type Grout (circle one): <input checked="" type="checkbox"/> Cement, <input type="checkbox"/> Bentonite, or Mix		

LOG DATA	
TYPE OF LOG RUN (Circle One): Electric, Gamma Ray, Density, Sonic, Neutron, Other (Describe) _____	
Name of Organization Running Log	

SCREEN DATA		
Diameter - Inches 4"	Length - Feet 2-10' pcs	Slot Size - Inches .013
Screen Type SCH 40	Depth to Bottom - Feet 82' to 102'	

GEOLOGIC DATA (Office Use Only)			
Surface Elev.	Geologic Unit	Unit Thickness	Depth to Top
Subs. SWL	Date	Analysis	Aquifer Test
Driller's Remarks			
Top of Lap Pipe or Reduction in Casing			
IF TELESCOPED OR MORE THAN ONE SCREEN USE BACK PAGE			

DESCRIPTION OF FORMATIONS ENCOUNTERED	FROM	TO
Clay & Brown Sand	0	20
Brown sand	20	40
sand & gravel	40	60
gravel	60	80
gravel	80	102

FORMATION (continued)		TO
		
		
		
		
		
		
		

Dept. of Environmental Quality
Office of Land & Water Resources

IF MORE SPACE IS NEEDED, USE BACK