

BOLIVAR MISSISSIPPI BOARD OF WATER COMMISSIONERS

C-34

10-30-65 WATER WELL DRILLERS LOG

CODED

Date: 10/30, 1965, Driller: Delta Well Supply Co., Inc.
 (Name)
LOWRY SIMS

(1) Owner of Land	Description & Color of Materials Sand, Clay, Red Clay, Shell, etc.	Thick- ness Feet	Depth Feet
<u>Lowry Sims</u> (Name) <u>Cleveland</u> (Address)	Clay	75	
(2) Location: $\frac{1}{4}$, $\frac{1}{4}$, Sec. <u>33</u> T. <u>18</u> N. R. <u>5</u> W. <u>2</u> miles <u>South</u> of <u>Sumner</u> (distance) (direction) (Nearest Town)	Sand & gravel	60	135
	Rock	1	136
	Clay	10	146
	Rock	1	147
	Clay	119	266
	Rock	2	268
(3) Topography: <input checked="" type="checkbox"/> (Hilly) <input type="checkbox"/> (Flat) <input type="checkbox"/> (Level)	Shale + Clay	137	405
(4) Purpose of Well: <u>Domestic</u> (Domestic Irrigation Municipal, Industrial, Other)	Sand & Shell	65	470
	Clay	43	513

Information upon completion of well:

- (1) Diameter 4 1/2 inches.
- (2) Total Depth 461 feet.
- (3) Water Level 21 feet below top of ground.
- (4) Cased to _____, Size _____.
- (5) Screen: Size 2, Length 20 ft.
- (6) Were any formations sealed against pollution?
 _____ yes, _____ no.

If YES depth of formation _____


Why _____

Drillers Remarks: _____

_____ in G. P. M.:

_____ e power:

_____ ps irrigated & Acreage: _____

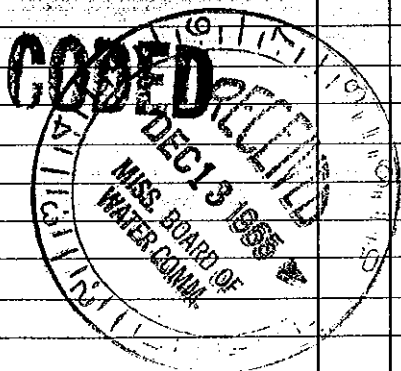

(Use Back Side)

Well No.

Mail this copy to Board of Water Commissioners 429 Miss. St. Jackson, Miss.