

BOLIVAR MISSISSIPPI BOARD OF WATER COMMISSIONERS *coded*

1-8-63

C 37-74 WATER WELL DRILLERS LOG *CODED* 1463

Date: January 8, 1963, Driller: Layne-Central Company County Bolivar

(Name)

	Description & Color of Materials Sand, Clay, Red Clay, Shell, etc.	Thick- ness Feet	Depth Feet
(1) Owner of Land: <u>W. S. Adams</u> (Name) <u>Rosedale, Mississippi</u> (Address)	Sandy clay	40	40
(2) Location: <u>1/4, 1/4, Sec. 25 T. 24N. R. 8W</u>	Coarse sand	12	52
<u>1.5</u> miles <u>north</u> of <u>Rosedale</u> (distance) (direction) (Nearest Town)	Coarse sand, pea gravel	26	78
(3) Topography: <u>flat</u> (Hilly) (Flat) (Level)	Gravel and sand	34	112
(4) Purpose of Well: <u>irrigation</u> (Domestic Irrigation, Municipal, Industrial, Other)			

CODED

Information upon completion of well:

(1) Diameter 16 inches.

(2) Total Depth 112 feet.

(3) Water Level 18' - 7" feet below top of ground.

(4) Cased to 62', Size 16"


(5) Screen: Size 16", Length 50'

(6) Were any formations sealed against pollution?
 yes, no

If YES depth of formation _____

Why _____

Drillers Remarks: _____

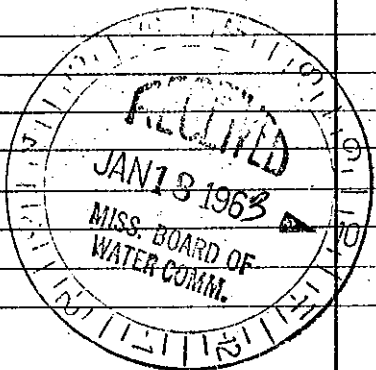

(Use Back Side)

Well No.

Mail this copy to Board of Water Commissioners 429 Miss. St. Jackson, Miss