

**BOLIVAR** MISSISSIPPI BOARD OF WATER COMMISSIONERS

C 39 ~~78~~

6-19-63

**WATER WELL DRILLERS LOG**

CODED  
7/25/63  
~~8/16/63~~

Date: June 19, 1963, Driller: Layne-Central Company County Bolivar  
(Name)

| (1) Owner of Land: <u>Edward Harris</u>   | Description & Color of Materials<br>Sand, Clay, Red Clay, Shell, etc. | Thick-<br>ness<br>Feet | Depth<br>Feet |
|---|---|------------------------|---------------|
| (Name)  | Clay  | 12                     | 12            |
| <u>Gunnison, Mississippi</u>  | Coarse sand   | 33                     | 45            |
| (Address)   | Coarse sand, pea gravel   | 30                     | 75            |
| (2) Location: <u>1/4</u> , <u>1/4</u> , Sec. <u>11</u> T <u>24N</u> R <u>7W</u> | Pea gravel & small  |                        |               |
| <u>2</u> miles <u>east</u> of <u>Gunnison</u>                                   | boulders  | 47                     | 122           |
| (distance) (direction) (Nearest Town)   |   |                        |               |
| (3) Topography: <u>flat</u>   |   |                        |               |
| (Hilly) (Flat) (Level)  |   |                        |               |
| (4) Purpose of Well: <u>irrigation</u>  |   |                        |               |
| (Domestic Irrigation Municipal, Industrial, Other)                              |   |                        |               |

CODED


Information upon completion of well:

- (1) Diameter 16x12 inches.
- (2) Total Depth 122 feet.
- (3) Water Level 16' - 1/4" feet below top of ground.
- (4) Cased to 62', Size 16"
- (5) Screen: Size 12", Length 60'
- (6) Were any formations sealed against pollution?  
no yes, no no.

If YES depth of formation \_\_\_\_\_

Why \_\_\_\_\_

Drillers Remarks: \_\_\_\_\_

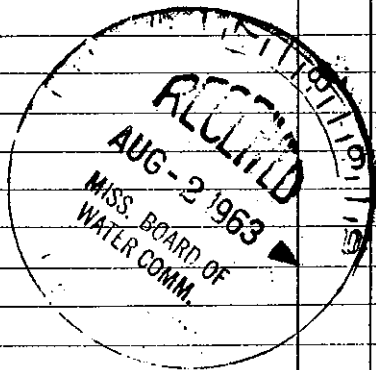

Well No.

(Use Back Side)

Mail this copy to Board of Water Commissioners 429 Miss. St. Jackson, Mis