

VOLIAR MISSISSIPPI BOARD OF WATER COMMISSIONERS
 E L D S # 9
 USGS
CODED
 46
 3-61
 W 3057
 WATER WELL DRILLERS LOG
 Date: March, 1961, Driller: Robert E. Rottiff County Calhoun
 (Name)

(1) Owner of Land:	Description & Color of Materials Sand, Clay, Red Clay, Shell, etc.	Thick- ness Feet	Depth Feet
<u>town of Lumberton</u> (Name)	<u>Lumbo</u>	<u>0-20</u>	
<u>Lumberton, Miss.</u> (Address)	<u>Fine Sand</u>	<u>20-60</u>	
(2) Location: <u>NE 1/4, SW 1/4, Sec. 8 T24R7</u>	<u>Sand & Limestone</u>	<u>60-165</u>	
_____ miles _____ of <u>City</u> (distance) (direction) (Nearest Town)	<u>Shale</u>	<u>165-250</u>	
(3) Topography: _____ (Hilly) (Flat) (Level)	<u>Fine Sand</u>	<u>250-265</u>	
(4) Purpose of Well: <u>municipal</u> (Domestic Irrigation Municipal, Industrial, Other)	<u>Shale</u>	<u>265-390</u>	
	<u>Sand</u>	<u>390-400</u>	
	<u>Lumbo</u>	<u>400-404</u>	
	<u>Sand</u>	<u>404-467</u>	


Information upon completion of well:

- (1) Diameter 10" inches.
- (2) Total Depth 469 feet.
- (3) Water Level 20 feet below top of ground.
- (4) Cased to 404, Size 10"
- (5) Screen: Size 6, Length 50
- (6) Were any formations sealed against pollution?
 yes, _____ no.

If YES depth of formation 10" casing
 Why was cemented in place

Drillers Remarks:

CODED

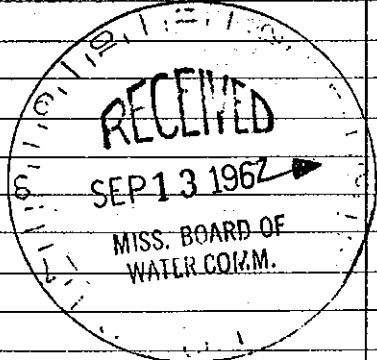

Well No.

(Use Back Side)

Mail this copy to Board of Water Commissioners 429 Miss. St. Jackson, Miss